

Well

Operator

Location

County

State

Field

Footages

IONE 8-2-8

EnCana Oil & Gas (USA) Inc.

NENE Section 8-T2N-R66W

WELD

Colorado

Wattenberg

160' FNL; 170' FEL

Spud Date:

12-06-12


TD Date:

12-10-12

Log Tops

Sussex	4671'
Niobrara	7292'
Codell	7567'
J Sand	8008'

Production Tubing
2-3/8" tubing, set @7993'

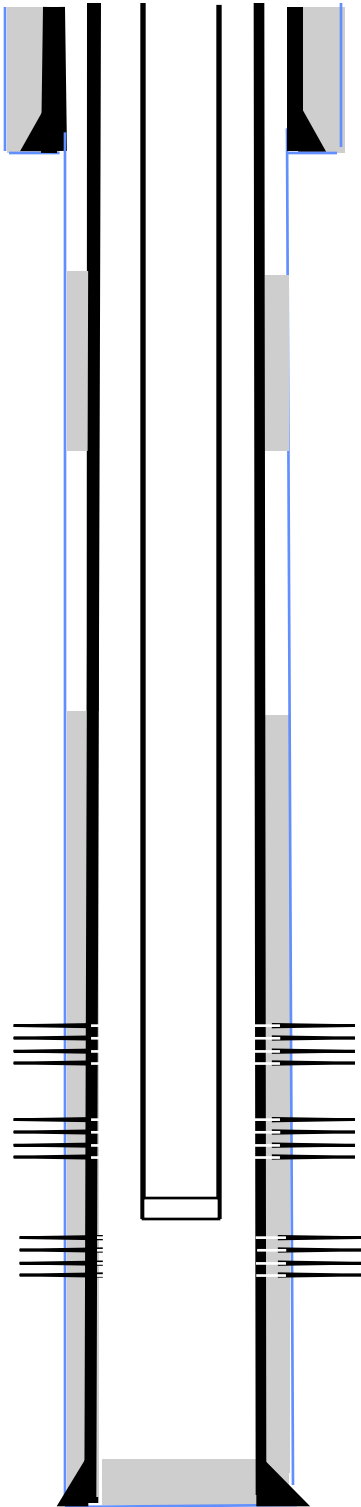

Surface Casing and Cement
8 5/8" , 24#, landed @ 838',cemented with 325 sxs

Main Hole
7-7/8" to TD

Production Casing and Cement
4-1/2", 11.6#, landed @ 8180' cemented with 640 sxs
250sxs

CBP
Set @ 7300'. 03-16-13
Drilled out on 03-16-13

Perf'd the Niobrara from 7342' – 7356' @ 2 spf
Frac'd the Niobrara with 253,400# 30/50, with 3277
bbls total fluid. 02-16-13

CFP
Set @ 7390'. 02-15-13
Drilled out on 03-16-13

Perf'd the Codell from 8007' – 8013', 8031' – 8080 '@ 2 spf
Frac'd the Codell with 250,080# 30/50 with 2794
bbls total fluid. 02-15-13

CFP
Set @ 7635'. 02-15-13
Drilled out on 03-16-13

Perf'd the J Sand 8020' – 8025', 8033' – 8053' @ 2 spf
Frac'd the J Sand with 250,600# 20/40, with 3865 bbls total fluid.
02-15-13

8192' — Driller's TD