




Lat40°, Inc. 1635 Foxtrail Drive, Suite 325 Loveland, CO 970-776-3321

WELL LOCATION CERTIFICATE


THIS MAP DOES NOT REPRESENT A BOUNDARY SURVEY

SECTION: 22
TOWNSHIP: 5N
RANGE: 65W

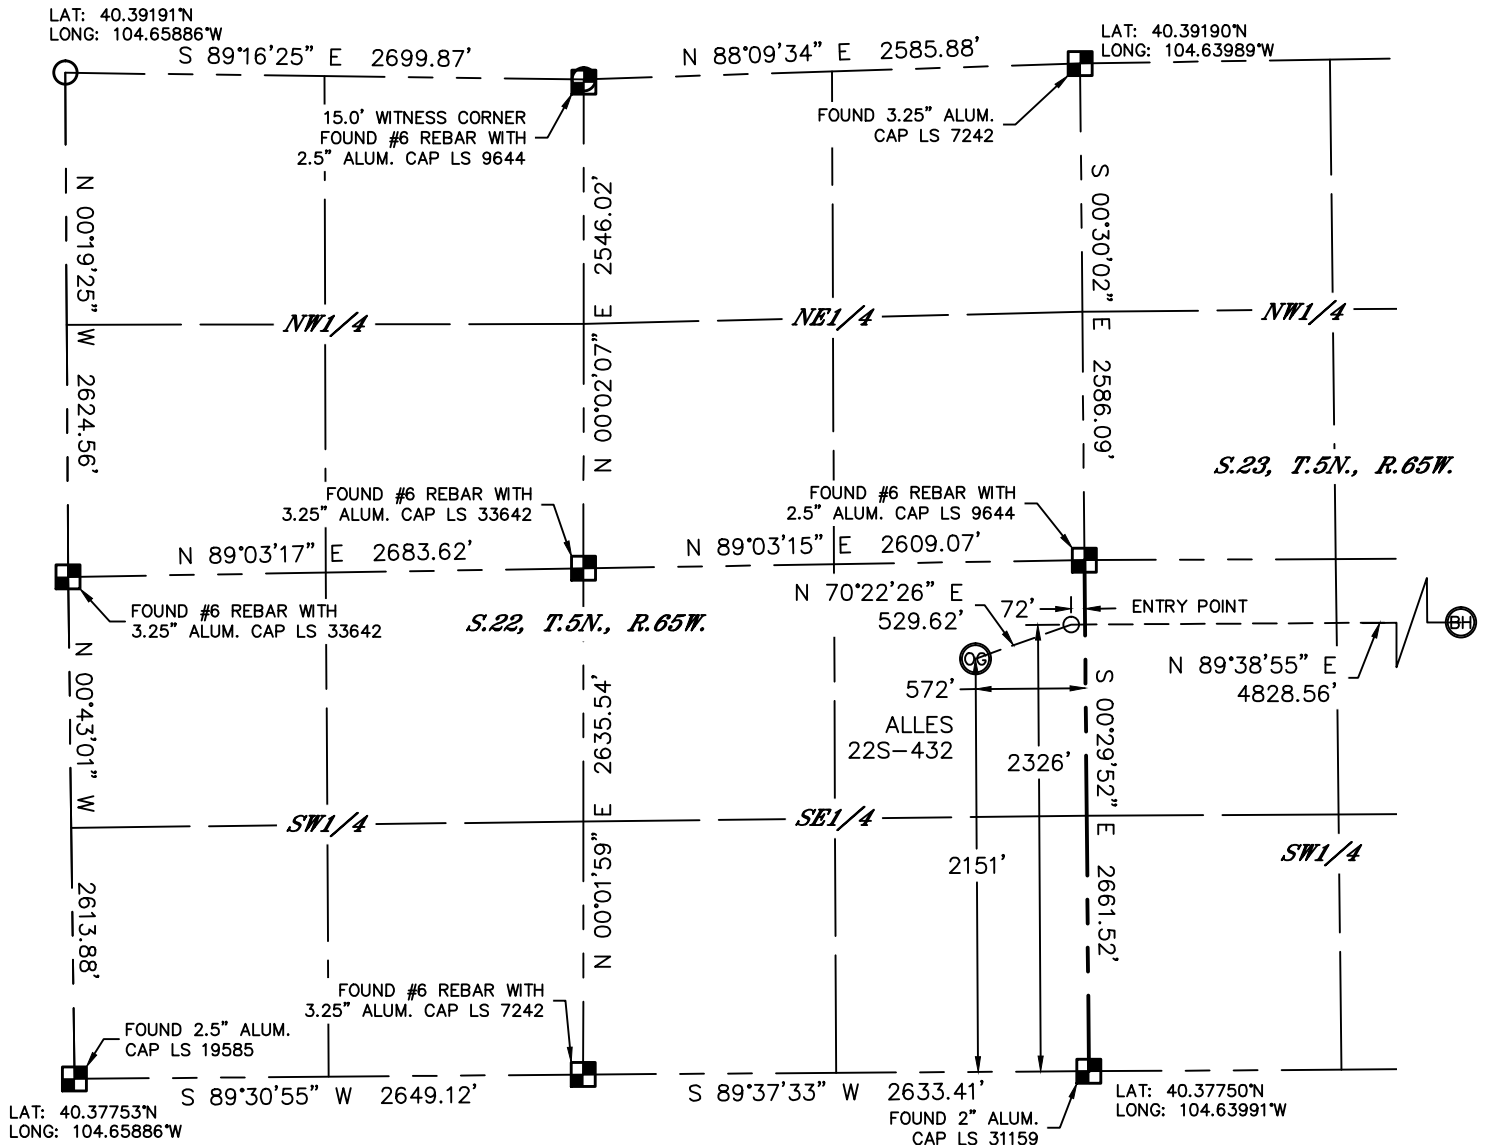

In accordance with a request from MARK ALESSI with PDC ENERGY Lat40°, Inc. has determined the surface location of the ALLES 22S-432 to be 2151' from the SOUTH line and 572' from the EAST line as measured at right angles from the section lines of Section 22, Township 5 North, Range 65 West and the bottom hole to be 2326' from the SOUTH line and 500' from the EAST line as measured at right angles from the section lines of Section 23, Township 5 North, Range 65 West of the Sixth Principal Meridian, County of Weld, State of Colorado.

I hereby state that this Well Location Certificate was prepared by me, or under my direct supervision, that the fieldwork was completed on 3/20/2013, for and on behalf of PDC ENERGY. That this is not a Land Survey Plat or an Improvement Survey Plat, and that it is not to be relied upon for establishment of fence, building, or other future improvement lines.

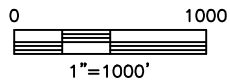

NOTE:

- 1) Bearings shown are Grid Bearings of the Colorado State Plane Coordinate System, North Zone, North American Datum 1983/2007. The lineal dimensions as contained herein are based upon the "U.S. Survey Foot."
- 2) Ground elevations are based on an observed GPS elevation (NAVD 1988 DATUM).
- 3) IMPROVEMENTS: See LOCATION DRAWING for all visible improvements within 400' of disturbed area.
- 4) SURFACE USE: CROPLAND
- 5) INSTRUMENT OPERATOR: BRIAN ROTTINGHAUS

NOTE

According to Colorado law, you must commence any legal action based upon any defect in this W.L.C. within three years after you discover such defect. In no event, may any action based upon any defect in this survey be commenced more than ten years after the date of the certificate shown hereon. (13-80-105 C.R.S.)

LEGEND

- = ALIQUOT MONUMENT AS DESCRIBED
- = CALCULATED POSITION

SURFACE LOCATION


LAT: 40.38341°N
LONG: 104.64195°W
PDOP: 1.5
ELEV: 4645'
1/4, 1/4: NE1/4SE1/4
NEAREST PROPERTY LINE:
195' SOUTHWEST

ENTRY POINT

LAT: 40.38389°N
LONG: 104.64016°W

BOTTOM HOLE

LAT: 40.38384°N
LONG: 104.62283°W

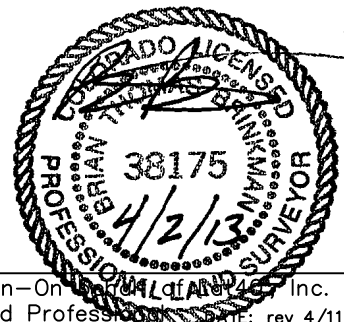

SHEET 1 OF 2

Brian T. Brinkman—On behalf of Lat40°, Inc.
Colorado Licensed Professional Surveyor No. 38175
DATE: rev 4/11/2013
PROJECT#: 2013036


Lat40°, Inc. 1635 Foxtrail Drive, Suite 325 Loveland, CO 970-776-3321

WELL LOCATION CERTIFICATE

THIS MAP DOES NOT REPRESENT A BOUNDARY SURVEY

SECTION: 22
TOWNSHIP: 5N
RANGE: 65W

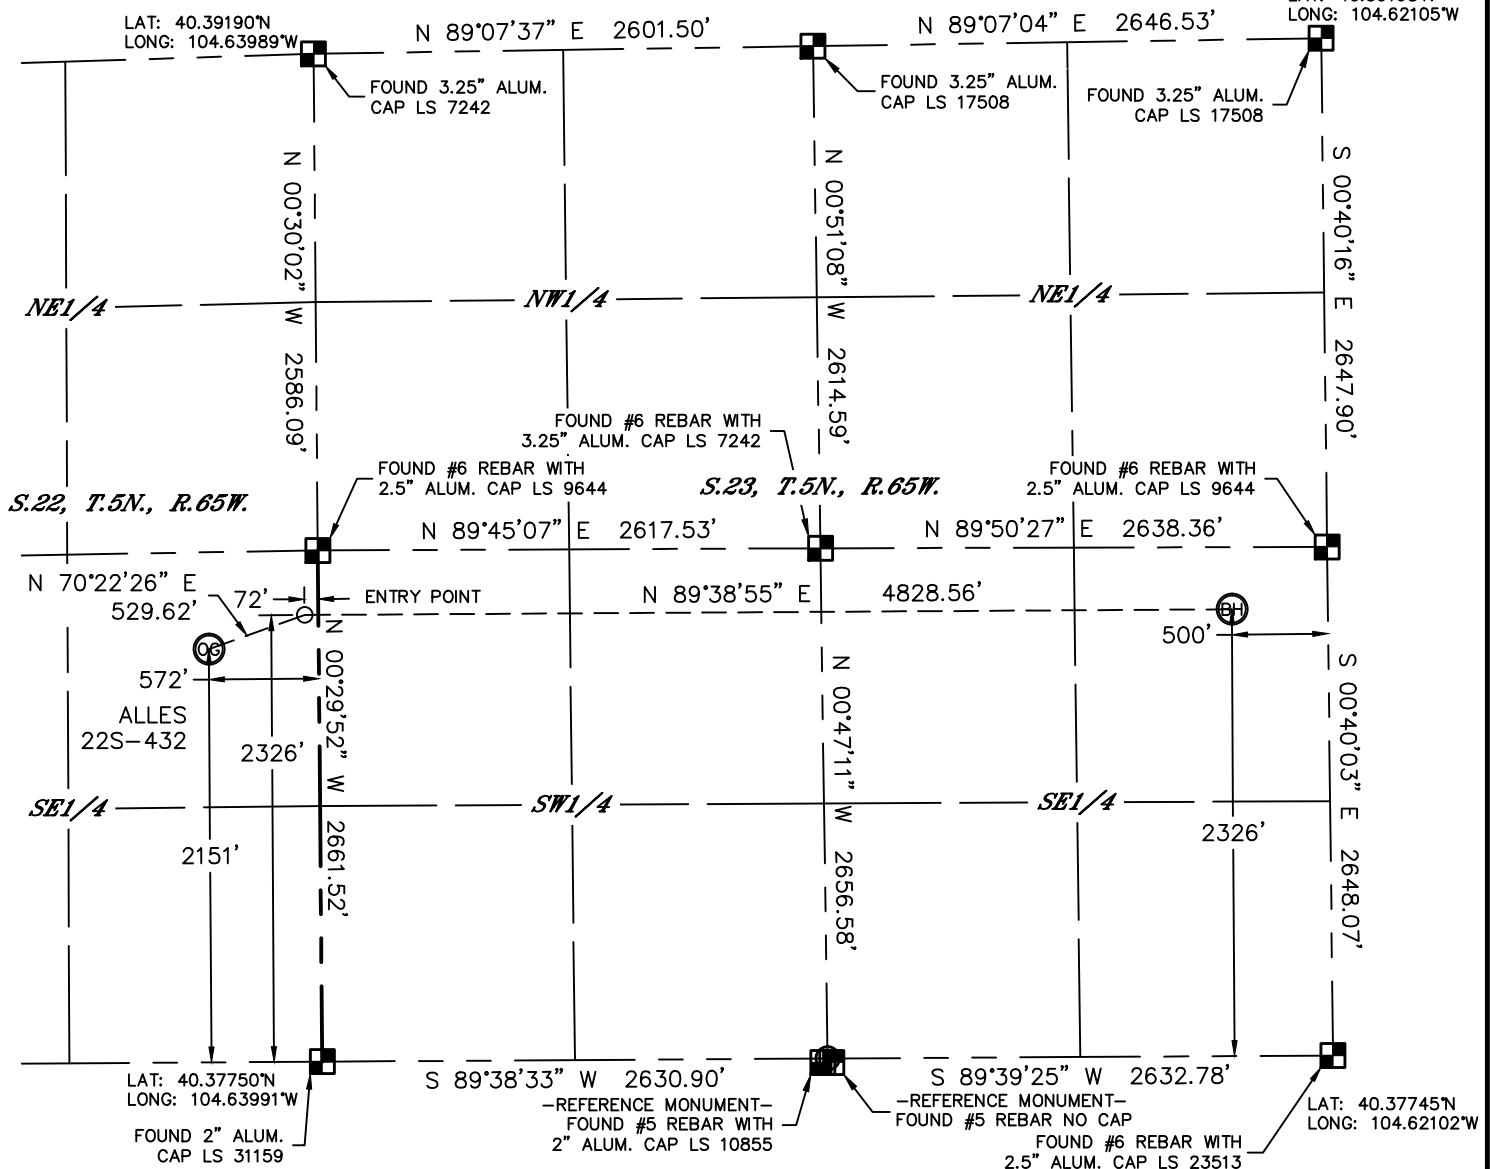

LAT: 40.39198°N
LONG: 104.62105°W



NOTE


NOTE According to Colorado law, you must commence any legal action based upon any defect in this W.L.C. within three years after you discover such defect. In no event, may any action based upon any defect in this survey be commenced more than ten years after the date of the certificate shown hereon. (13-80-105 C.R.S.)

LEGEND

-  = ALIQUOT MONUMENT AS DESCRIBED
 = CALCULATED POSITION

SHEET 2 OF 2

Colorado Licensed Professional Surveyor No. 38175
DATE: rev 4/11/2013
PROJECT#: 2013036

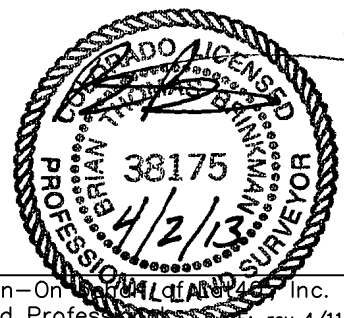




Lat40°, Inc. 1635 Foxtrail Drive, Suite 325 Loveland, CO 970-776-3321

SITE SKETCH

ALLES 22S-432

SECTION: 22
TOWNSHIP: 5N
RANGE: 65W

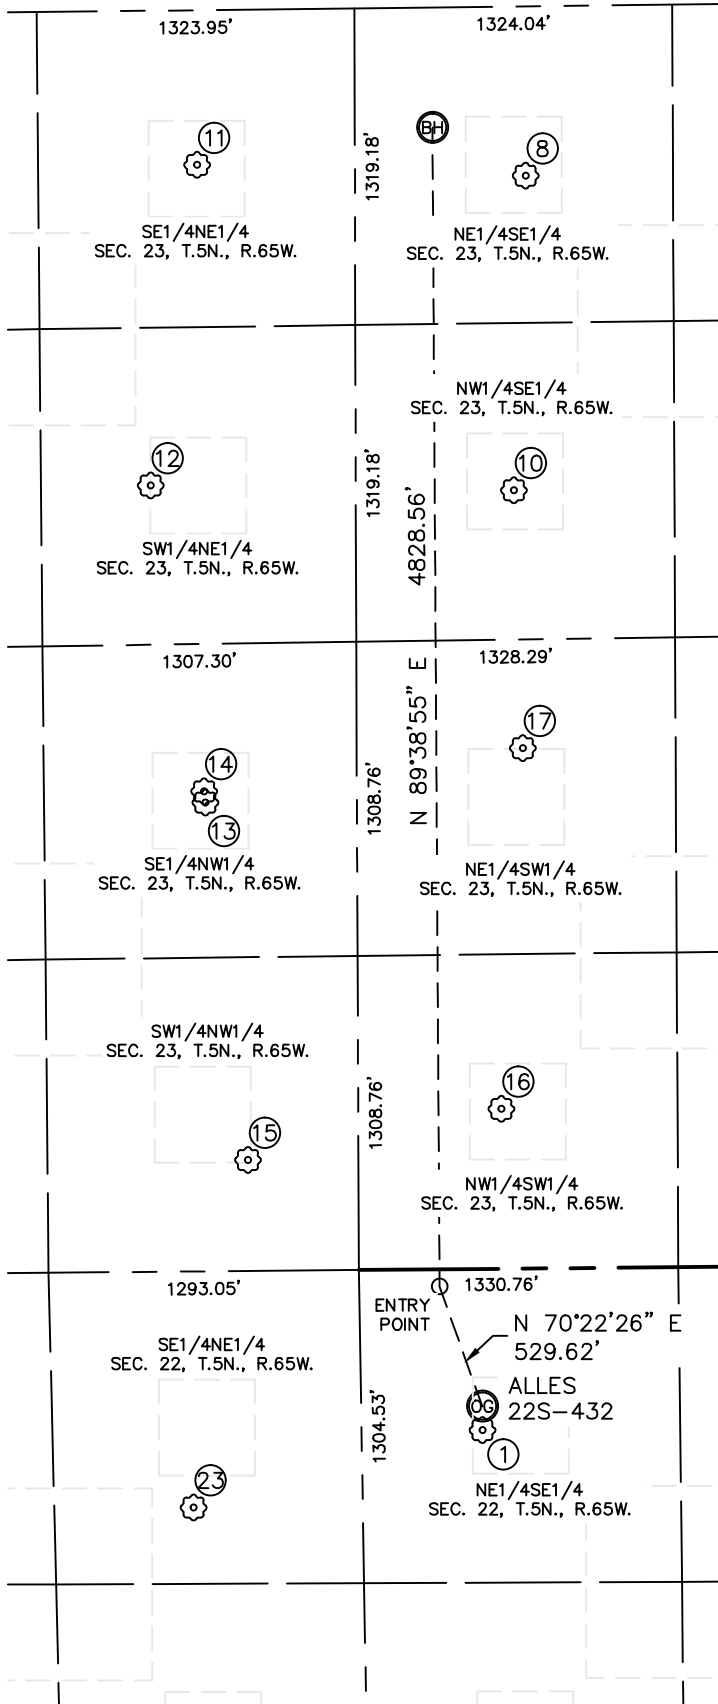

①
ALLES 9-22
NE1/4SE1/4
2152' FSL
672' FEL
LAT-40.38341°N
LONG-104.64231°W
PDOP: 1.5
ELEV: 4646'

⑧
ESTHER 1-23
NE1/4SE1/4
1940' FSL
705' FEL
LAT-40.38278°N
LONG-104.62356°W
PDOP: 1.7
ELEV: 4641'

⑩
LILLIE 1-23
NW1/4SE1/4
1996' FSL
2016' FEL
LAT-40.38295°N
LONG-104.62827°W
PDOP: 1.9
ELEV: 4643'

⑪
SUSAN 1-23
SE1/4NE1/4
1982' FNL
645' FEL
LAT-40.38653°N
LONG-104.62336°W
PDOP: 2.0
ELEV: 4639'

⑫
ALLES 23-13
SW1/4NE1/4
1768' FNL
1978' FEL
LAT-40.38710°N
LONG-104.62814°W
PDOP: 2.6
ELEV: 4639'

⑬
DOLL F 23-20D
SE1/4NW1/4
1976' FNL
1952' FWL
LAT-40.38651°N
LONG-104.63289°W
PDOP: 2.2
ELEV: 4642'


⑭
DOLL 23-1
SE1/4NW1/4
1971' FNL
2000' FWL
LAT-40.38652°N
LONG-104.63272°W
PDOP: 2.4
ELEV: 4642'

⑮
DOLL PM F 23-5
SW1/4NW1/4
2130' FNL
462' FWL
LAT-40.38606°N
LONG-104.63824°W
PDOP: 2.1
ELEV: 4643'

⑯
BUDERUS 12-23
NW1/4SW1/4
2064' FSL
665' FWL
LAT-40.38316°N
LONG-104.63751°W
PDOP: 2.3
ELEV: 4645'

⑰
BADLEY 23-31
NE1/4SW1/4
1966' FSL
2168' FWL
LAT-40.38288°N
LONG-104.63212°W
PDOP: 1.8
ELEV: 4643'

⑳
RIVER 1
SE1/4NE1/4
1865' FNL
984' FEL
LAT-40.38672°N
LONG-104.64343°W
PDOP: 1.2
ELEV: 4639'

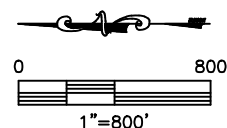

DATE: rev 4/11/2013
PROJECT#: 2013036