



Physical Address: 345 Comanche St.
Mail to: Box 384, Kiowa, CO 80117
Ph. 303-621-8672 - Fax 303-621-7749
www.highprairiesurvey.com


Job # 12122 Evan #2

Inv # 2476

High Prairie Surveying of Kiowa, Colorado has in accordance with a request from **Pronghorn Operating LLC** has determined the location of **Evan #2** to be 731 feet FNL, and 1856 feet FEL, (90° off Section lines) of **SECTION 7**, Township **14s**, Range **44w** of the 6th Principal Meridian, **Cheyenne County**, Colorado.

Date: Staked on 6/14/13 drawn on 6/20/13.

Re: Staked by Keith Westfall
Drawn: Drawn by Dustin Cotter

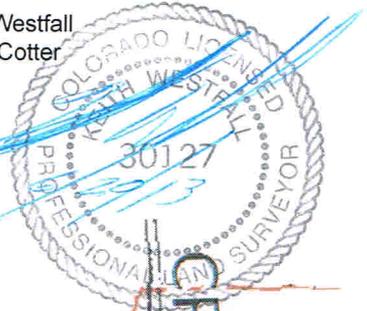

Access Road Map

