High Prairie Survey Co.

Physical Address: 345 Comanche St.
Mail to: Box 384, Kiowa, CO 80117
Ph. 303-621-8672 - Fax 303-621-7749
www.highprairiesurvey.com

Job # 12122 Evan #2 Inv # 2476

High Prairie Surveying of Kiowa, Colorado has in accordance with a request from **Pronghorn Operating LLC** has determined the location of **Evan #2** to be 731 feet FNL, and 1856 feet FEL, (90° off Section lines) **of** SECTION **7**, Township **14s**, Range **44w** of the 6th Principal Meridian, **Cheyenne County**, Colorado.

Date: Staked on 6/14/13 drawn on 6/20/13.

Re: Staked by Keith Westfall
Drawn: Drawn by Dustin Cotter

Basis of Elevation Spot: USGS BM = H 12, PID = JJ0627, H-Order = Third, V-Order = Code A, Stability = Unknown, P-DOP = 2.6, Sats = 7 US NAD 83 CO-C, Lat. = 38.88446, Long. = W102.35200, Elevation = 4322.74 gr. (us FT).

Notes: There are no apparent improvements within 400 ft of proposed well pad..
The ground elevation at staked location = 4295.10' gr.
This drawing does not represent a monumented survey or Land Survey Plat.

Basis of Bearing: Bearings were determined based on the North line of the Northeast 1/4 of Section 7 to bear N 87°29'55" E with all other bearings contained herein relative thereto.
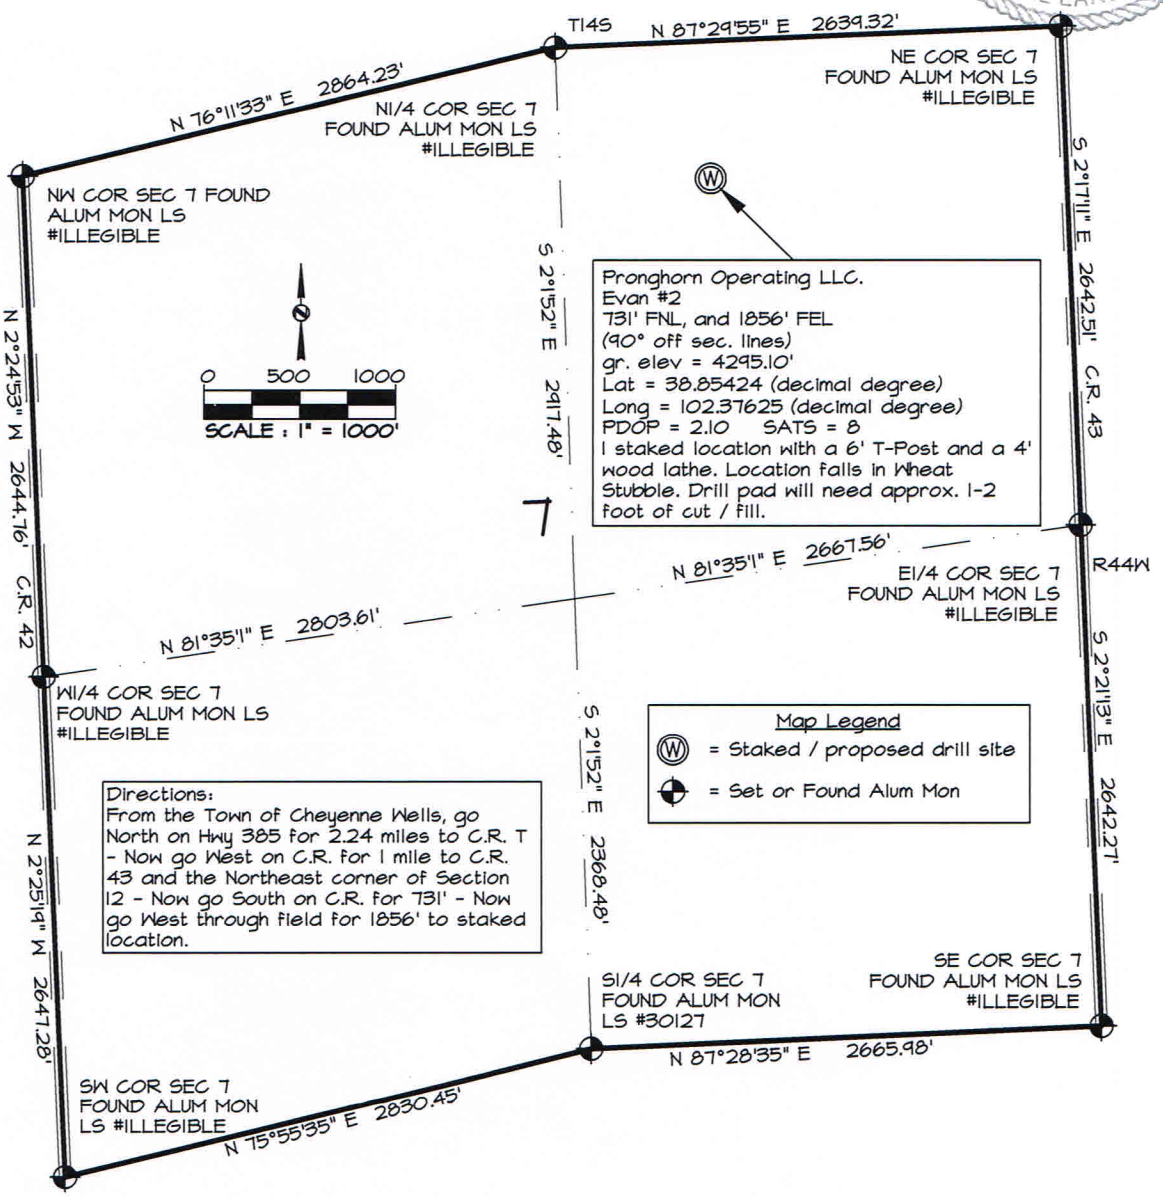
COLORADO LICENSED KEITH WESTFALL 30127 PROFESSIONAL LAND SURVEYOR