

KERR-MCGEE OIL AND GAS ONSHORE LP

KIEFER GEORGE W UT B#2A

SE SW 13 1N 67W -- --

WELD,COLORADO

06/12/2013

AREA: S3

ROUTE: S33 Spud: 04/06/1977

WINS No.: 74529

AFE/WO#: 88367962

API#: 0512309160

GL: 4927

KB: 4939

MTD: 8103


TVD: 8103

LOG MD: 8017

PBMD: 8017

PBTVD: 8017

Directions: WCR 23 & WCR 8, E 2/10, N 1/10, E INTO

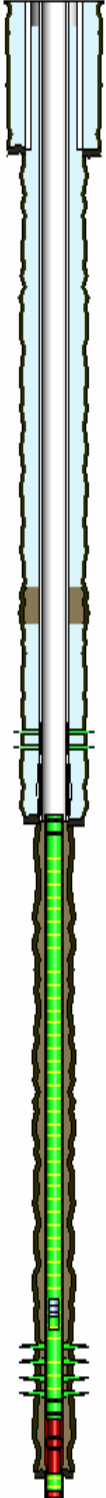

HOLE SECTIONS	Size	Top	Btm	TD Date
SURFACE	12.25	12	980	04/06/1977
PRODUCTION	7.88	980	4817	04/09/1977
DEEPENED	3.88	4817	8103	01/18/2001

TUBULARS	Tool Type	Joints	Size	Weight	Grade	Thread	Top D	Bottom D
SURFACE CASING	Casing	24	8.63	24			12	972
PRODUCTION CASING	Casing	150	4.50	10.5	?	?	12	4817
DEEPENED LINER	Liner Hanger	1					4773	4778
	Liner	106	2.88	6.5	N-80	8RD EUE	4778	8067
	Landing Collar	1	2.88				8067	8068
	Liner	1	2.88	6.5	N-80	8RD EUE	8068	8099
	Casing Guide Shoe	1	2.88				8099	8100
PRODUCTION TUBING	Tubing	251	1.66	4.7	J-55		12	7915
	Seating Nipple	1	1.66				7915	7916
	Notched Collar	1	1.66		J-55		7916	7917

CEMENT JOBS	Stage	Sacks	Cement Jobs	Top D	Btm D	cbl
SURFACE CASING	STAGE 1			12	972	No
PRODUCTION CASING	STAGE 1	250	50/50 POZ-MIX	4031	4817	No
--None--	STAGE 1			0	0	Yes
	STAGE 1 TAIL			0	0	Yes
PRODUCTION CASING	ONE INCH JOB	733	LEAD FRESH WATER	170	3790	Yes

PERFORATIONS	Formation	Zone	Top	Btm	Date	Reason	Comments
	SUSSEX		4684	4710	05/02/1977	PRODUCTION	
	J SAND		7962	7968	01/24/2001	PRODUCTION	
	J SAND		7974	7998	01/24/2001	PRODUCTION	

Comments: