


Well Name: DINNEL 02

VERTICAL - ORIGINAL HOLE, 6/26/2013 9:05:12 AM

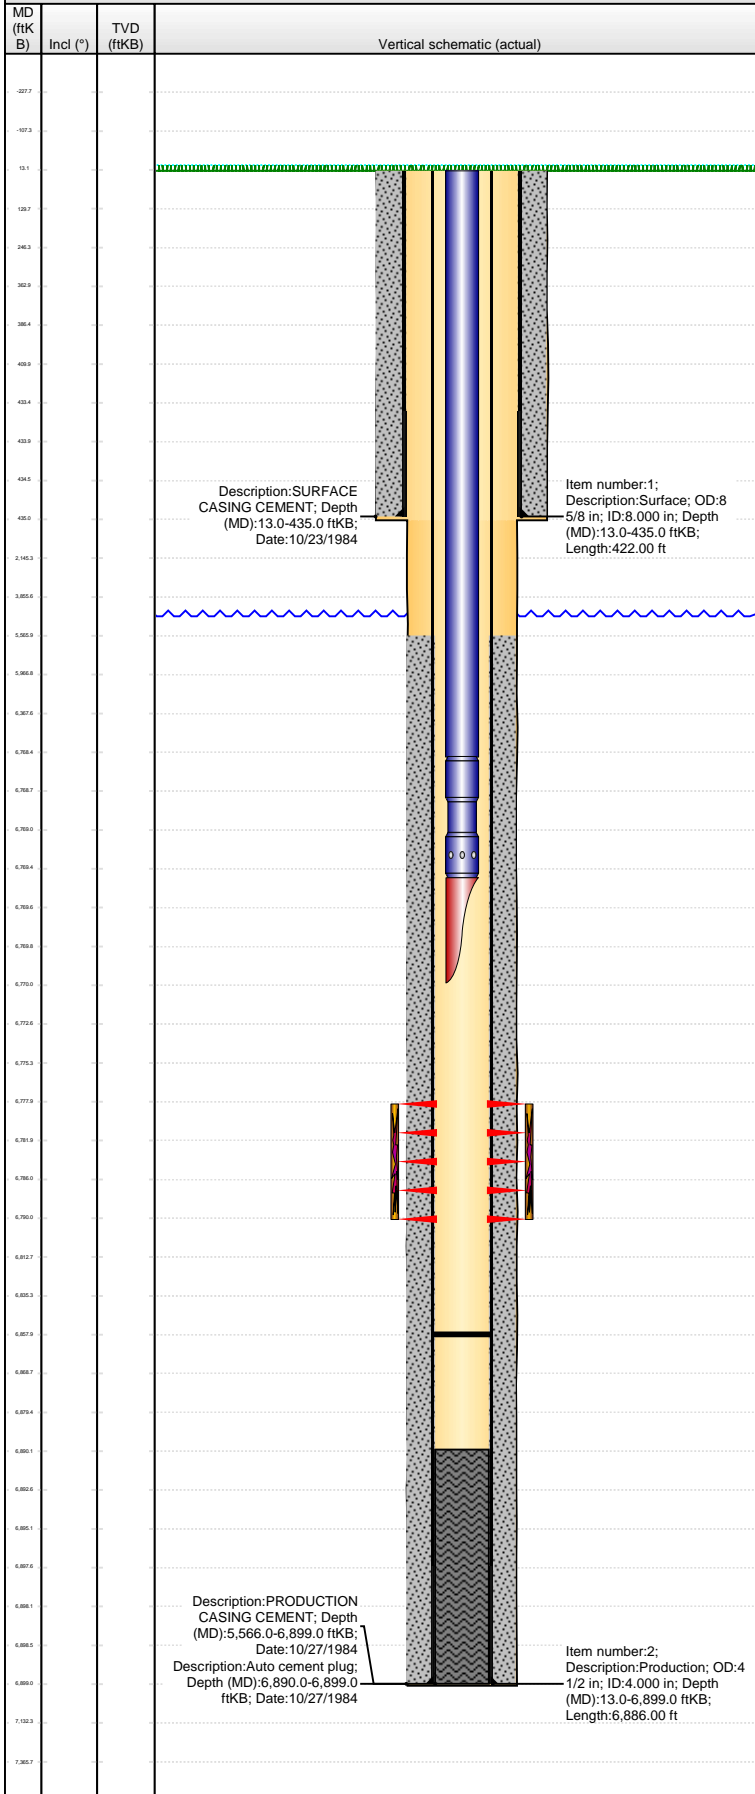

Well Header									
API 05-123-12070		Business Unit WATTENBERG		District 15		Well Config VERTICAL			
Original KB Elevation (ft) 4,684.00		KB - GL / MSL (ftKB) 13.00		Spud Date 10/23/1984		P & A Date			
Comment WELL FILE MINIMAL & SKETCHY, HOLE IN CASING. TUBING STUCK IN HOLE. SEE REPORT									
Directions To Well RD 42 & 57, S 100', E 4 /10, S INTO.									
Congressional Location									
Quarter 1	Quarter 2	Quarter 3 NE	Quarter 4 NW	Section 26	Township 4 N	Twntshp N...	Range 64	Rng E/W Dir W	
Bottom Hole Location									
North-South Distance (ft)			From N or S Line		East-West Distance (ft)			From E or W Line	
Plug Back Total Depths									
Date	Depth (ftKB)		Method		Com				
10/27/1984	6,890.0		TAG						
11/6/1984	6,858.0		CASED HOLE LOG		DEPTH LOGGER ON CBL				
Wellbore Sections									
Section Des			Size (in)		Act Top (ftKB)		Act Btm (ftKB)		
SURFACE			12 1/4		13.0		440.0		
PRODUCTION			7 7/8		440.0		6,908.0		
Zone Statuses									
Zone Name		Status Date		Status		Job			
CODELL		11/29/1984		PR		DRILLING/COMPLETION - ORIGINAL, 10/23/1984 00:00			
Casing Strings									
Surface, 435.0ftKB									
Casing Description		Run Date	OD (in)	Wt/Len (l...	Grade	Top (ftKB)	MD (ftKB)		
Surface		10/23/1984	8 5/8	24.00	J-55	13.0	435.0		
Production, 6,899.0ftKB									
Casing Description		Run Date	OD (in)	Wt/Len (l...	Grade	Top (ftKB)	MD (ftKB)		
Production		10/27/1984	4 1/2	10.50	J-55	13.0	6,899.0		
Cement									
Description					Top Depth (ftKB)		Bottom Depth (ftKB)		
SURFACE CASING CEMENT					13.0		435.0		
Description					Top Depth (ftKB)		Bottom Depth (ftKB)		
PRODUCTION CASING CEMENT					5,566.0		6,899.0		
Tubing Components									
Item Des		OD (in)	Wt (lb/ft)	Grade	Jts	Len (ft)	Btm (ftKB)	Btm (TVD) (ftKB)	
Tubing		2 3/8	4.70	J-55	207	6,755.40	6,768.4		
Pump Seating		2 3/8			1	1.00	6,769.4		
Nipple									
Mule Shoe		2 3/8			1	0.60	6,770.0		
Perforation Data									
Zone		Bnch/St g	Entered Shot Total	Top (ftKB)		Btm (ftKB)		Date	
CODELL, ORIGINAL HOLE			13	6,778.00		6,790.00		11/6/1984	
Stimulations & Treatments									
Date	Zone				Primary Job Type				
11/19/1984	CODELL, ORIGINAL HOLE				DRILLING/COMPLETION - ORIGINAL				
Technical Result			Tech Result Details			Tech Result Note			
Comment									
Other In Hole									
Run Date		Des			OD (in)	Top (ftKB)		Btm (ftKB)	
Logs									
Date		Type				Top (ftKB)		Btm (ftKB)	
10/27/1984		COMPENSATED DENSITY				6,450.0		6,902.0	
10/27/1984		INDUCTION				435.0		6,908.0	
11/6/1984		CEMENT BOND				5,450.0		6,852.0	
3/14/2011		GYRO				10.0		6,700.0	