


Well Name: LOUSTALET B15-16


VERTICAL - ORIGINAL HOLE, 6/26/2013 11:02:23 AM

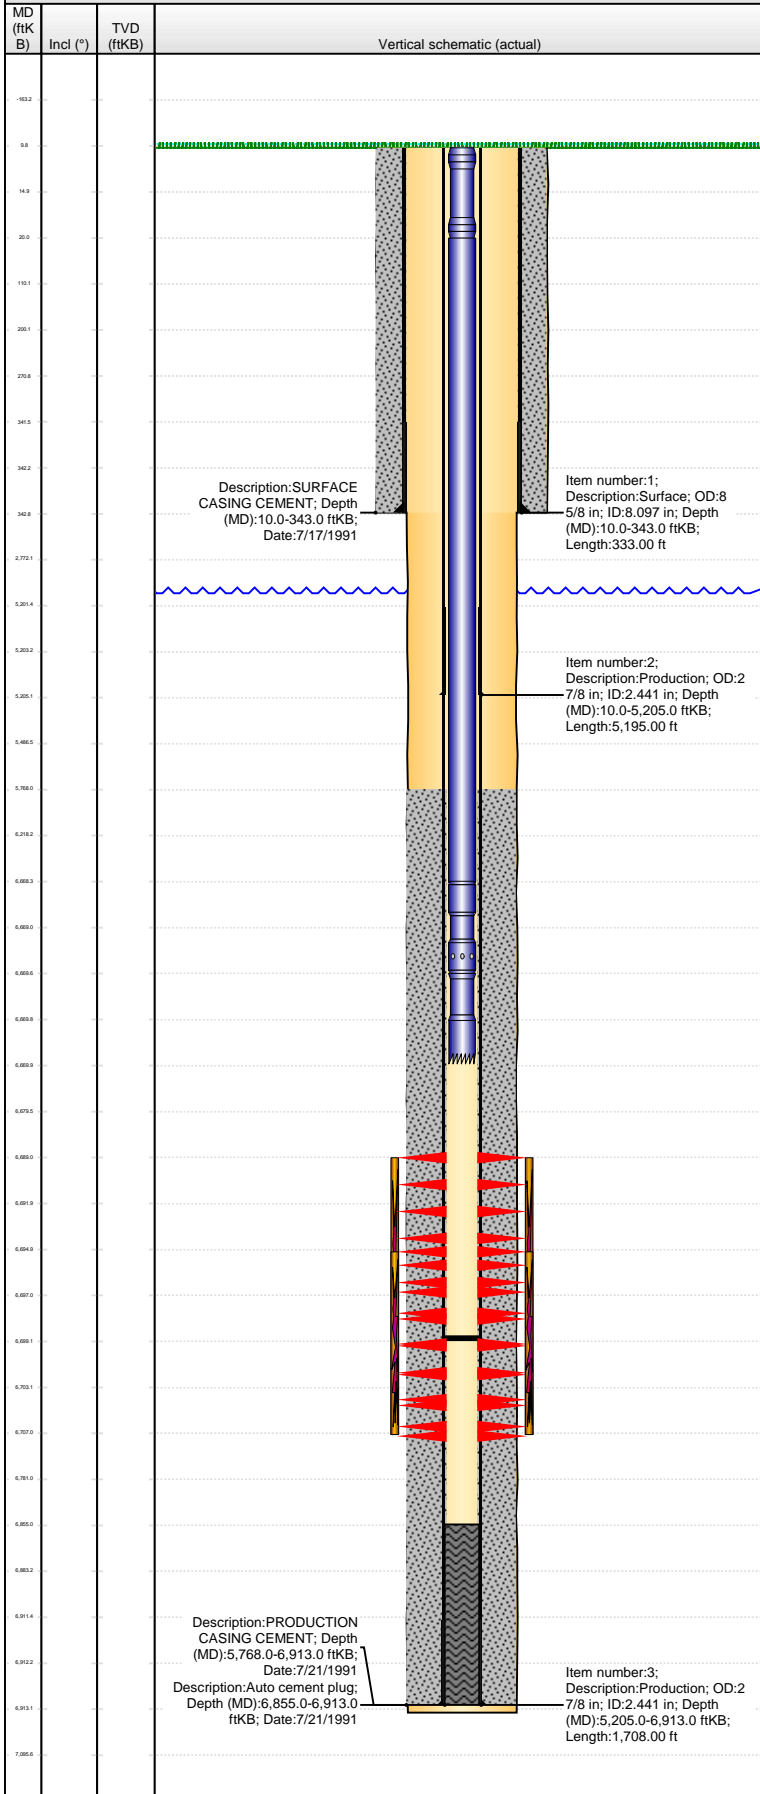

Well Header								
API 05-123-15015		Business Unit WATTENBERG		District 15		Well Config VERTICAL		
Original KB Elevation (ft) 4,581.00		KB - GL / MSL (ftKB) 10.00		Spud Date 7/17/1991		P & A Date		
Comment Csg rpr 5/01 patch @ 5196 (Trifrac - 10/12/11 dumped 6 sks Frac Sand down csg, used to clean out rust from frac string)								
Directions To Well HWY 34 & RD 56, EAST 6/10 ON RD 56, NORTH 2/10 TO YELLOW CATTLE GAURD. GO EAST THROUGH YELLOW CATTLE CATTLE GAURD 2/10 TO TANK BATTERY, CONTINUE EAST FROM TANK BATTERY 2/10 AND THEN SOUTH INTO.								
Congressional Location								
Quarter 1	Quarter 2	Quarter 3 SE	Quarter 4 SE	Section 15	Township 5 N	Twntshp N...	Range 64	Rng E/W Dir W
Bottom Hole Location								
North-South Distance (ft)		From N or S Line		East-West Distance (ft)			From E or W Line	
Plug Back Total Depths								
Date	Depth (ftKB)	Method			Com			
7/29/1991	6,855.0	CASED HOLE LOG			DEPTH LOGGER ON CBL			
4/21/2003	6,699.0	TAG			FILL			
Wellbore Sections								
Section Des			Size (in)		Act Top (ftKB)		Act Btm (ftKB)	
SURFACE			12 1/4		10.0		355.0	
PRODUCTION			7 7/8		355.0		6,932.0	
Zone Statuses								
Zone Name		Status Date		Status		Job		
CODELL		8/8/1991		PR		DRILLING/COMPLETION - ORIGINAL, 7/17/1991 00:00		
CODELL		4/29/2003		PR		RE-FRAC, 4/17/2003 00:00		
CODELL		10/11/2011		PR		TRI-FRAC, 10/10/2011 15:00		
Casing Strings								
Surface, 343.0ftKB								
Casing Description Surface		Run Date 7/17/1991	OD (in) 8 5/8	Wt/Len (l... 24.00	Grade ?	Top (ftKB) 10.0	MD (ftKB) 343.0	
Production, 5,205.0ftKB								
Casing Description Production		Run Date 5/1/2001	OD (in) 2 7/8	Wt/Len (l... 6.50	Grade N-80	Top (ftKB) 10.0	MD (ftKB) 5,205.0	
Production, 6,913.0ftKB								
Casing Description Production		Run Date 7/21/1991	OD (in) 2 7/8	Wt/Len (l... 6.50	Grade N-80	Top (ftKB) 5,205.0	MD (ftKB) 6,913.0	
Cement								
Description SURFACE CASING CEMENT					Top Depth (ftKB) 10.0		Bottom Depth (ftKB) 343.0	
Description PRODUCTION CASING CEMENT					Top Depth (ftKB) 5,768.0		Bottom Depth (ftKB) 6,913.0	
Tubing Components								
Item Des		OD (in)	Wt (lb/ft)	Grade	Jts	Len (ft)	Btm (ftKB)	Btm (TVD) (ftKB)
Pup Joint		1.9	2.75	J-55	1	10.00	20.0	
Tubing		1.9	2.75	J-55	203	6,648.29	6,668.3	
Seal Nipple		1.9	2.75	J-55	1	1.32	6,669.6	
Notched collar		1.9	2.75	J-55	1	0.33	6,669.9	
Perforation Data								
Zone		Bnch/St g	Entered Shot Total	Top (ftKB)		Btm (ftKB)		Date
CODELL, ORIGINAL HOLE			40	6,689.00		6,707.00		8/1/1991
CODELL, ORIGINAL HOLE			52	6,695.00		6,707.00		4/22/2003
Stimulations & Treatments								
Date 8/1/1991	Zone CODELL, ORIGINAL HOLE			Primary Job Type DRILLING/COMPLETION - ORIGINAL				
Technical Result			Tech Result Details			Tech Result Note		
Comment								

Well Name: LOUSTALET B15-16

VERTICAL - ORIGINAL HOLE, 6/26/2013 11:02:24 AM

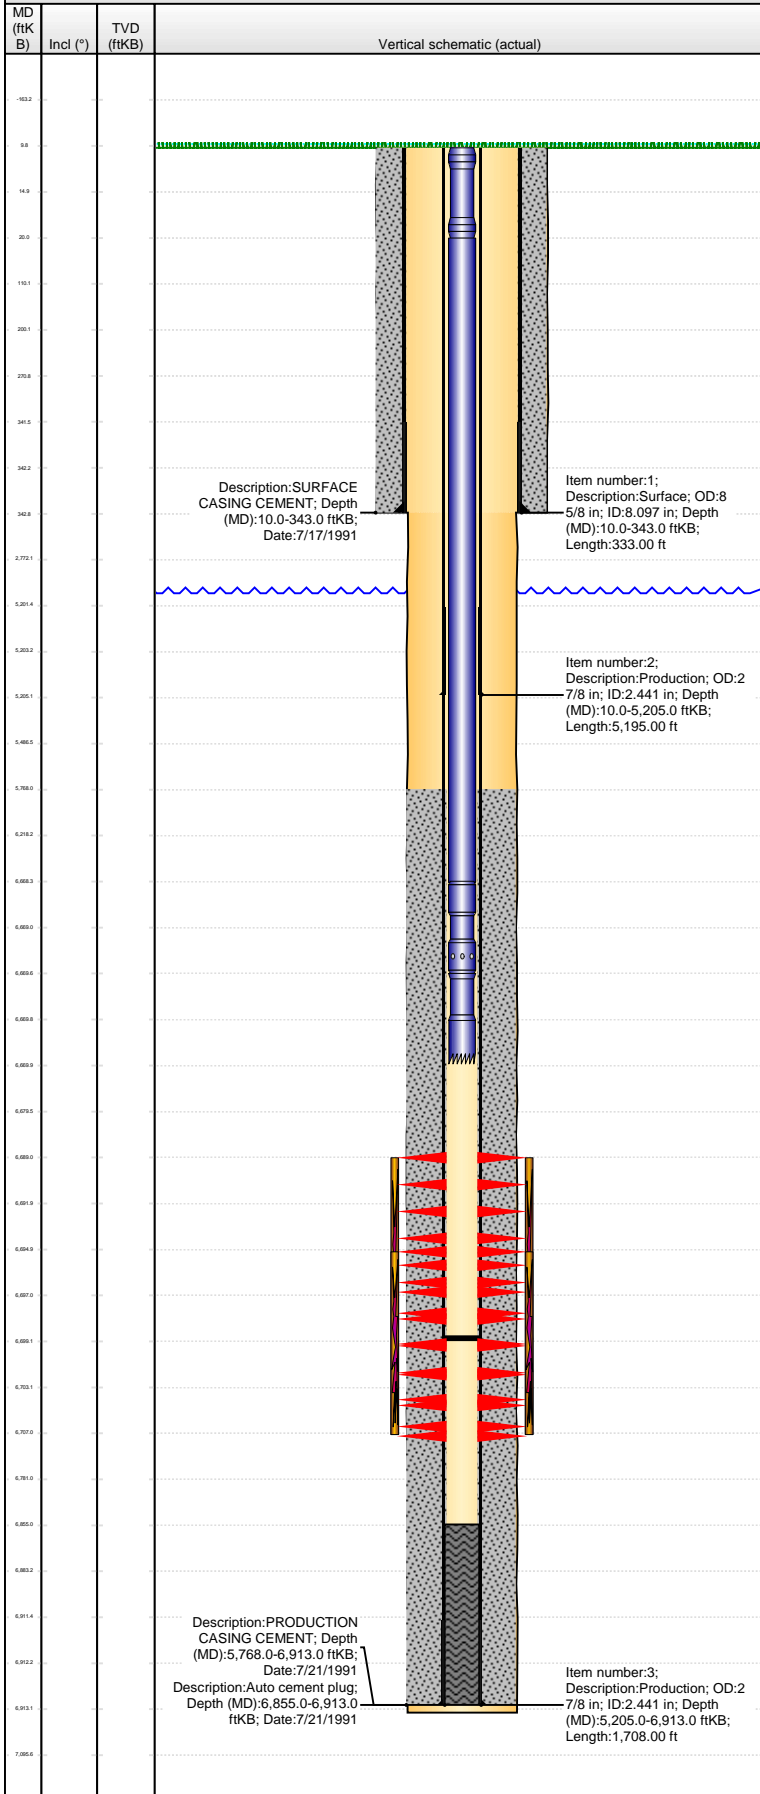

Stimulations & Treatments				
Date	Zone	Primary Job Type		
4/28/2003	CODELL, ORIGINAL HOLE	DRILLING/COMPLETION - ORIGINAL		
Technical Result		Tech Result Details		Tech Result Note
Comment				
Other In Hole				
Run Date	Des		OD (in)	Top (ftKB)
				Btm (ftKB)
Logs				
Date	Type		Top (ftKB)	Btm (ftKB)
7/21/1991	COMPENSATED DENSITY		3,834.0	6,932.0
7/29/1991	CBL/CCL/GR		5,650.0	6,853.0