



ENCANA OIL & GAS (USA) INC

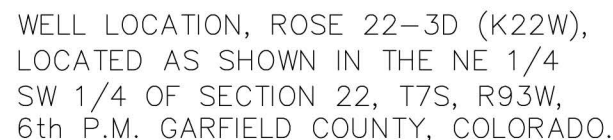

TARGET BOTTOM HOLE, ROSE 22-3D
(K22W), LOCATED AS SHOWN IN THE
NE 1/4 NW 1/4 OF SECTION 22, T7S,
R93W, 6th P.M. GARFIELD COUNTY,
COLORADO.

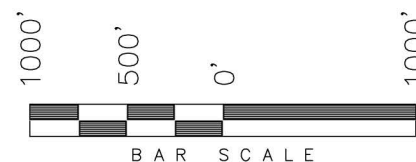

NOTES:

1. Well footages are measured at right angles to the Section Lines.
2. Bearings are based on Global Positioning Satellite observations.
3. G.P.S. Operator: C.D. Slauch, (PDOP) = 1.4

THIS IS TO CERTIFY THAT THE ABOVE PLAT WAS
PREPARED FROM FIELD NOTES AND SURVEYS
MADE BY ME OR UNDER MY SUPERVISION, THE LOCATION
HAS BEEN STAKED ON THE GROUND, AND THE
PLAT, AND THAT THE SO ARE TRUE AND CORRECT
TO THE BEST OF MY KNOWLEDGE AND BELIEF.

REGISTERED LAND SURVEYOR
REISTRATION NO. 30125
STATE OF COLORADO AND SURVEYOR

TRI STATE LAND SURVEYING & CONSULTING

180 NORTH VERNAL AVE. — VERNAL, UTAH 84078
(435) 781-2501

DATE SURVEYED:
03-08-13

SURVEYED BY: C.D.S.

SHIFT

DATE DRAWN:
05-06-13

DRAWN BY: M.W.

 $2m$

REVISÉ:

SCALE: 1" = 1000'

OF 8

 = SECTION CORNERS LOCATED

Basis of elevation is the Rifle 2 Triangulation Station. 39°31'53.80" N Lat. & 107°47'07.78" W Long. (NAD 83). Elevation = 5323.1' (NAVD88).

NAD 83 (SURFACE LOCATION)	
LATITUDE =	39°25'50.50" (39.430695°)
LONGITUDE =	107°45'41.53" (107.761537°)
NAD 83 (BOTTOM HOLE LOCATION)	
LATITUDE =	39°26'05.91" (39.434976°)
LONGITUDE =	107°45'41.35" (107.761486°)