Well 25BV #1

Original Hole, 6/21/2013 5:15:59 PM

MD (ftKB)	TVD (ftKB)	Incl (°)
-5.9	165.5	35.0
0.0	170.4	35.0
24.9	190.8	35.0
25.9	191.6	35.0
27.6	192.9	35.0
73.2	230.3	35.0
1,549.2	1,439.4	35.0
1,550.5	1,440.5	35.0
1,593.2	1,475.4	35.0
1,594.2	1,476.2	35.0
1,596.1	1,477.8	35.0
1,611.9	1,490.7	35.0
3,889.8	3,590.0	4.7
3,912.7	3,612.9	4.3
4,923.6	4,623.0	0.4
4,938.0	4,637.4	0.3
4,946.2	4,645.6	0.3
5,098.1	4,797.5	0.5
5,160.1	4,859.5	0.6
5,416.0	5,115.4	0.3
5,503.9	5,203.3	0.4
5,504.9	5,204.3	0.4
5,549.9	5,249.3	0.4
5,683.4	5,382.8	0.1
5,684.7	5,384.1	0.1
5,716.2	5,415.6	0.1
5,717.5	5,416.9	0.1
5,723.8	5,423.2	0.2
5,724.1	5,423.5	0.2
5,724.4	5,423.8	0.2
5,759.8	5,459.2	0.2
5,952.1	5,651.5	0.4
6,274.9	5,974.3	0.1
6,465.2	6,164.6	0.2
6,466.2	6,165.6	0.2
6,466.9	6,166.3	0.2
6,467.2	6,166.6	0.2
6,468.2	6,167.6	0.2
6,512.8	6,212.2	0.2
6,514.1	6,213.5	0.2
6,544.9	6,244.3	0.2

DLS

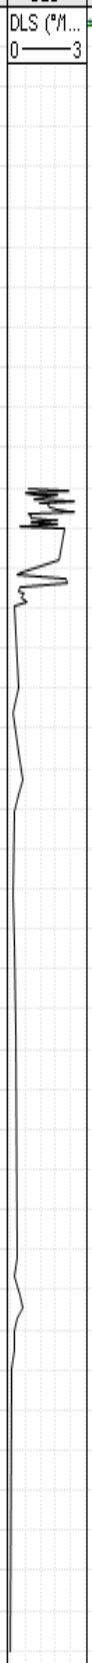

Vertical schematic (actual)

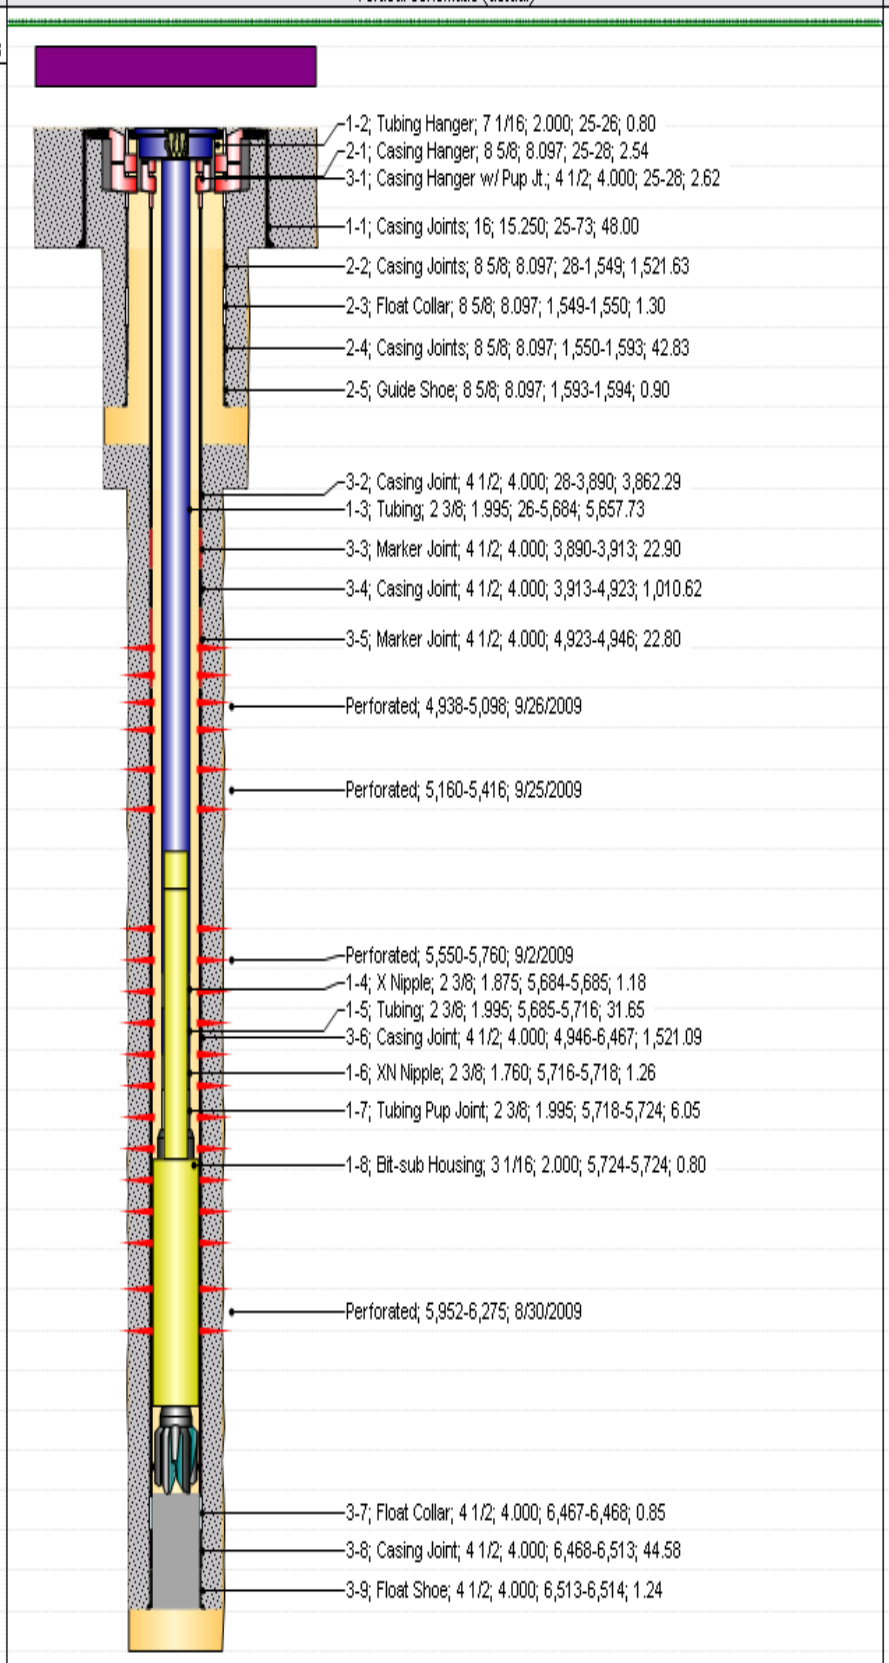

Formations - Final