Well 25BV #4

Original Hole, 6/21/2013 5:18:08 PM

MD (ftKB)	TVD (ftKB)	Incl (°)	DLS (°/1... 0 — 10
-5.9	-5.9	0.0	
0.0	0.0	0.0	
24.9	24.9	0.0	
25.9	25.9	0.1	
27.9	27.9	0.1	
28.9	28.9	0.1	
75.1	75.1	0.2	
1,040.7	1,021.4	17.6	
1,042.0	1,022.6	17.6	
1,084.0	1,062.6	17.6	
1,085.0	1,063.6	17.6	
1,100.1	1,078.0	17.6	
3,669.0	3,573.3	5.1	
3,688.6	3,593.0	4.8	
4,705.4	4,609.3	0.9	
4,727.7	4,631.6	0.9	
4,834.0	4,737.9	1.0	
5,074.1	4,978.0	1.2	
5,120.1	5,023.9	1.3	
5,379.9	5,283.7	0.8	
5,405.8	5,309.6	0.8	
5,458.0	5,361.8	0.7	
5,458.7	5,362.4	0.7	
5,460.0	5,363.7	0.7	
5,461.3	5,365.0	0.7	
5,492.8	5,396.5	0.7	
5,494.1	5,397.8	0.7	
5,500.0	5,403.7	0.7	
5,501.0	5,404.7	0.7	
5,708.0	5,611.7	0.8	
5,759.8	5,663.6	1.1	
6,042.0	5,945.6	1.8	
6,101.0	6,004.6	1.8	
6,200.1	6,103.7	1.8	
6,200.8	6,104.3	1.8	
6,202.1	6,105.6	1.8	
6,257.9	6,161.4	1.8	
6,258.9	6,162.4	1.8	
6,305.4	6,208.9	1.7	
6,306.8	6,210.2	1.7	
6,345.1	6,248.6	1.7	

Vertical schematic (actual)

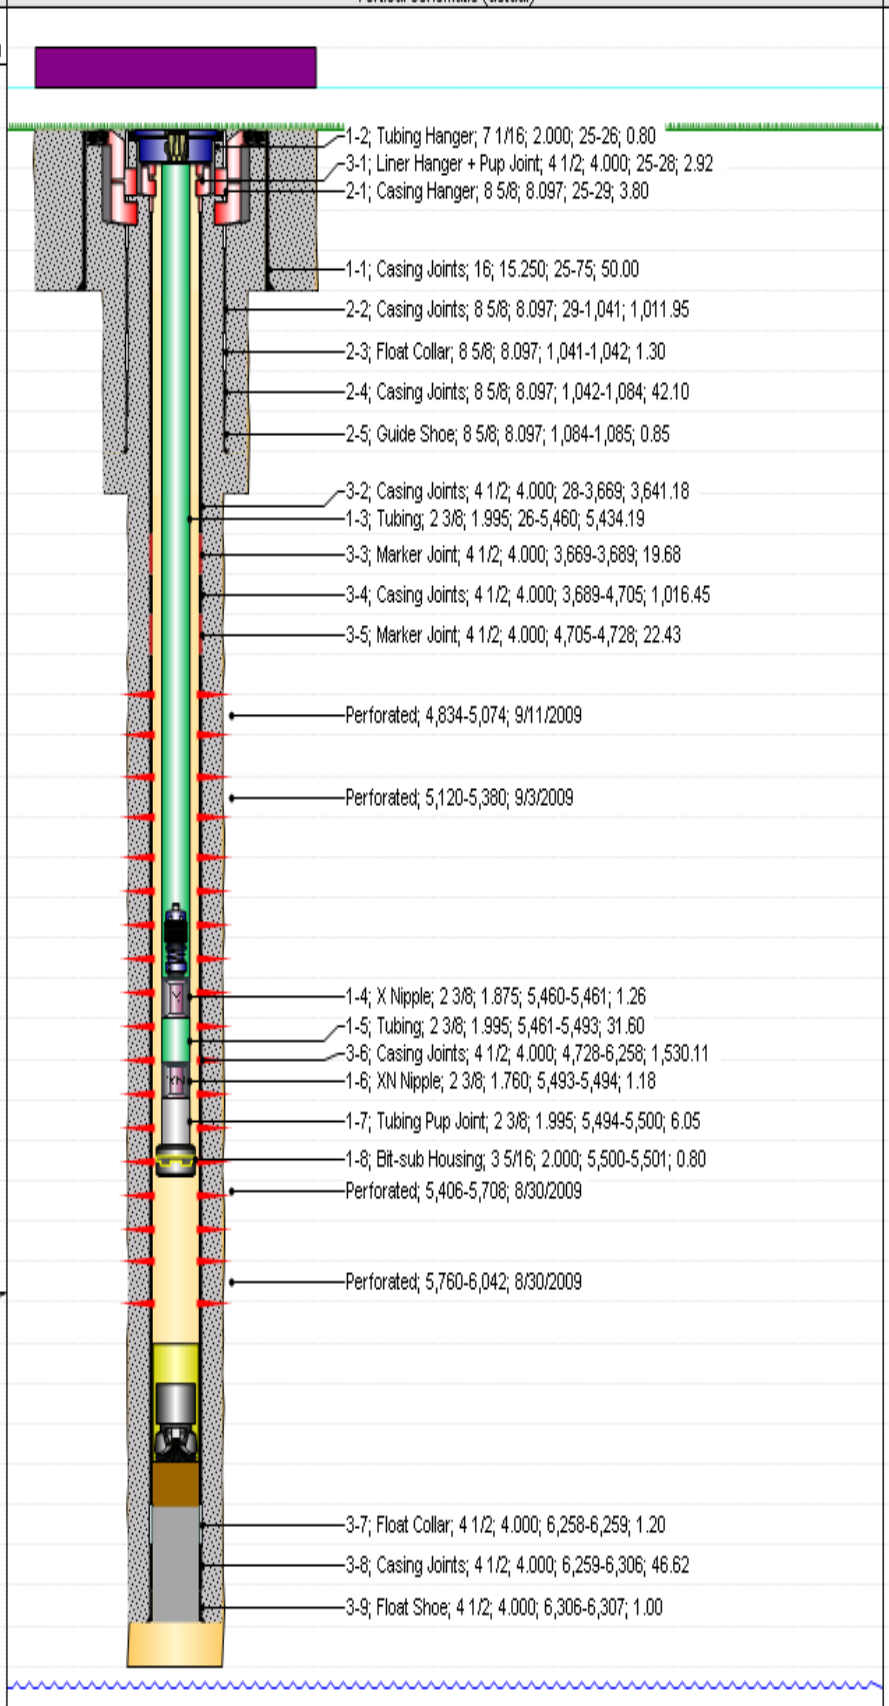

Formations - Final