Well 25BV #8

Original Hole, 6/21/2013 5:19:05 PM

MD (ftKB)	TVD (ftKB)	Incl (°)	DLS (°/1... 0 — 3
-5.9	-5.9	0.0	
0.0	0.0	0.0	
24.9	24.9	0.1	
25.9	25.9	0.1	
28.9	28.9	0.1	
75.1	75.1	0.2	
1,000.0	997.0	5.5	
1,012.5	1,009.4	5.5	
1,013.8	1,010.7	5.5	
1,055.8	1,052.5	5.5	
1,056.8	1,053.5	5.5	
1,075.1	1,071.8	5.5	
3,599.7	3,589.2	2.5	
3,621.4	3,610.8	2.5	
4,483.9	4,473.2	0.4	
4,631.9	4,621.2	1.1	
4,654.9	4,644.1	1.1	
4,722.1	4,711.4	1.1	
4,764.1	4,753.4	1.1	
5,036.1	5,025.3	1.2	
5,069.9	5,059.1	1.2	
5,071.9	5,061.0	1.2	
5,153.9	5,143.0	1.1	
5,450.1	5,439.3	1.0	
5,518.0	5,507.2	0.6	
5,519.4	5,508.5	0.6	
5,550.9	5,540.0	0.9	
5,552.2	5,541.3	0.9	
5,558.1	5,547.2	1.0	
5,559.1	5,548.2	1.0	
5,655.8	5,644.9	1.7	
5,687.0	5,676.1	1.8	
5,891.1	5,880.0	2.1	
5,967.8	5,956.7	2.2	
6,146.0	6,134.7	2.4	
6,146.7	6,135.4	2.4	
6,148.0	6,136.7	2.4	
6,181.1	6,169.8	2.4	
6,182.1	6,170.8	2.4	
6,229.3	6,218.0	2.4	
6,230.3	6,219.0	2.4	
6,250.0	6,238.6	2.4	

Vertical schematic (actual)

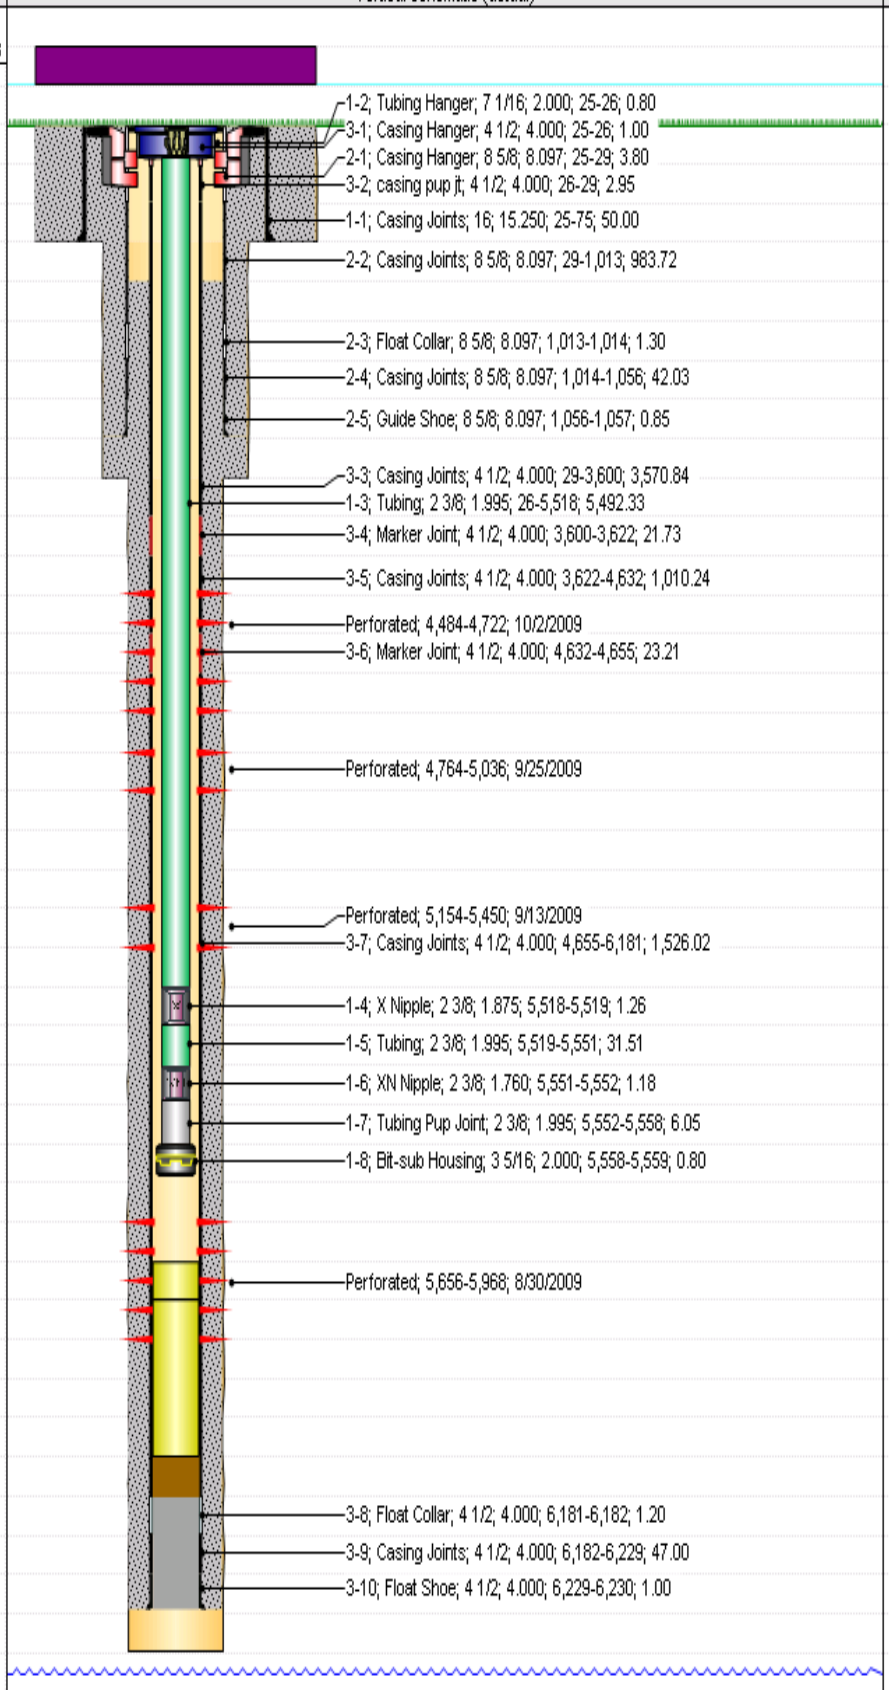

Formations - Final