Well 25BV #16

Original Hole, 6/21/2013 5:21:58 PM

MD (ftKB)	TVD (ftKB)	Incl (°)	DLS (°/1...
-5.9	-5.9	0.0	
0.0	0.0	0.0	
24.9	24.9	0.2	
25.9	25.9	0.2	
27.2	27.2	0.2	
28.2	28.2	0.2	
29.9	29.9	0.3	
67.9	67.9	0.6	
682.1	674.2	17.2	
1,413.1	1,319.4	36.0	
1,414.4	1,320.5	36.0	
1,452.1	1,351.0	36.0	
1,453.1	1,351.8	36.0	
1,464.9	1,361.4	36.0	
3,861.9	3,487.0	7.2	
3,884.2	3,509.1	6.8	
4,938.0	4,561.7	1.5	
4,960.6	4,584.4	1.5	
5,169.9	4,793.6	1.1	
5,377.0	5,000.6	1.5	
5,409.1	5,032.7	1.2	
5,562.0	5,185.6	1.1	
5,618.1	5,241.7	1.2	
5,810.0	5,433.6	1.5	
5,811.4	5,434.9	1.5	
5,842.2	5,465.7	1.3	
5,843.2	5,466.7	1.3	
5,849.4	5,472.9	1.3	
5,850.1	5,473.6	1.3	
5,914.0	5,537.5	1.0	
6,005.9	5,629.4	0.7	
6,326.1	5,949.5	2.1	
6,408.1	6,031.4	2.0	
6,463.9	6,087.2	1.9	
6,502.0	6,125.2	1.7	
6,502.6	6,125.9	1.7	
6,503.9	6,127.2	1.7	
6,504.6	6,127.8	1.7	
6,551.2	6,174.4	1.6	
6,552.2	6,175.4	1.6	
6,580.1	6,203.3	1.6	

Vertical schematic (actual)

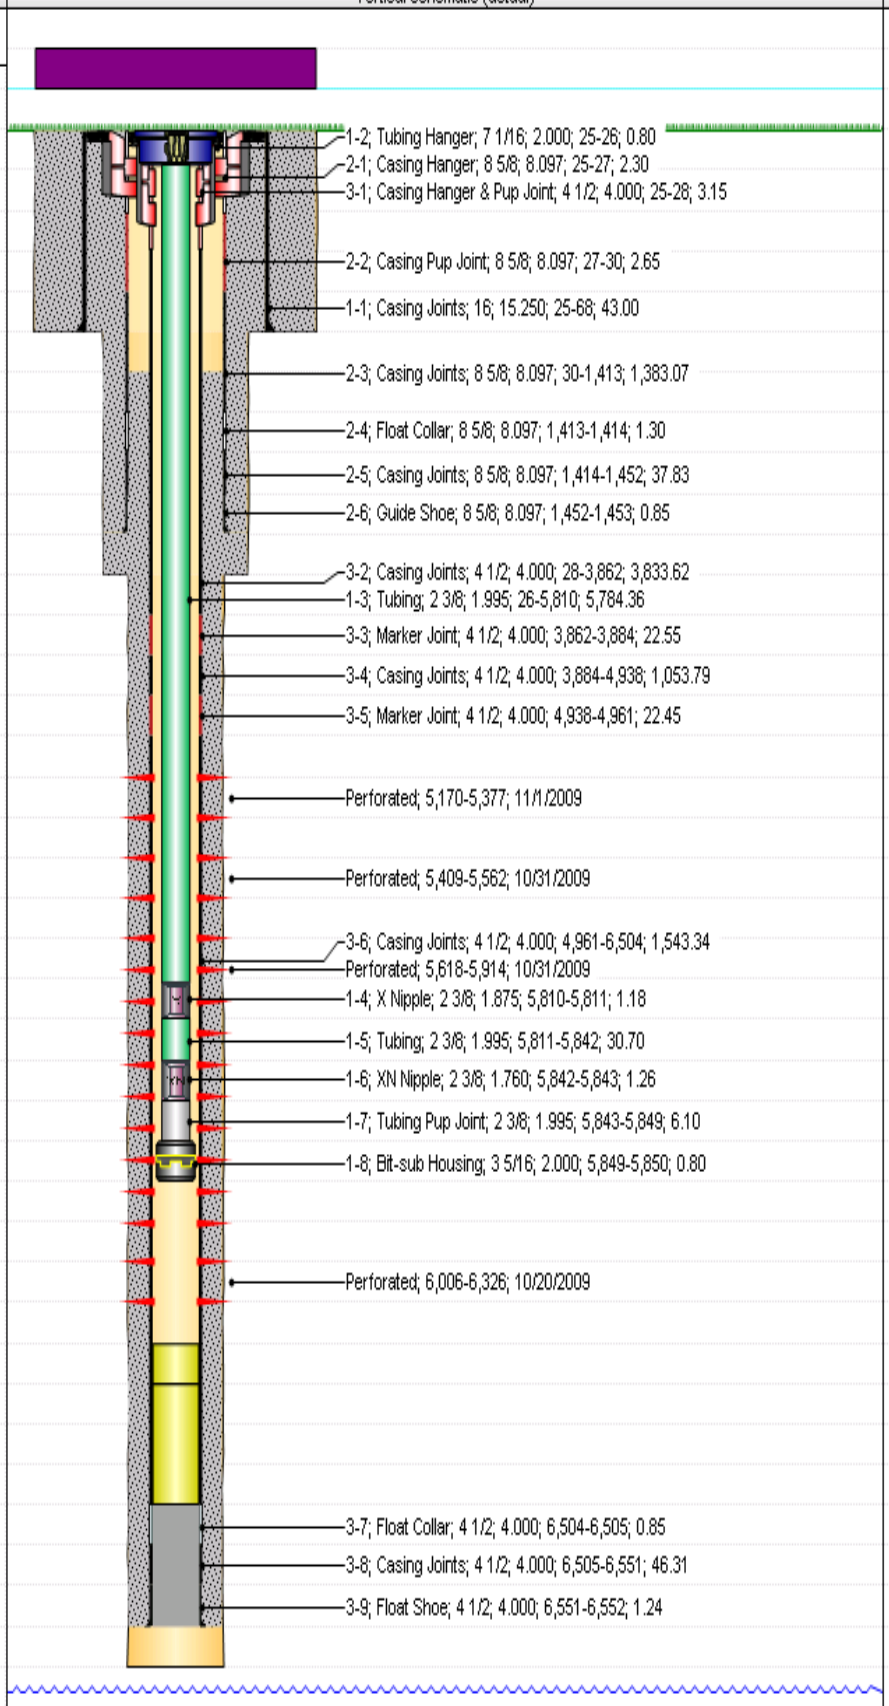

Formations - Final