

KERR-MCGEE OIL AND GAS ONSHORE LP

SHAKLEE GAS UNIT TRUE #1

SE SE 26 2N 65W 990' FSL 990' FEL

WELD,COLORADO

06/10/2013

AREA: S5

ROUTE: S51

Spud: 11/14/1983

WINS No.: 75349

AFE/WO#: 2082193

API#: 0512311505

GL: 4920

KB: 4934

MTD: 7818


TVD: 7818

LOG MD:

PBMD: 7773

PBTVD: 7773

Directions: WCR 47 & WCR 16, NW INTO

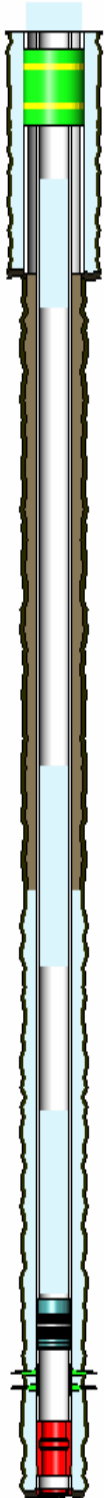

HOLE SECTIONS	Size	Top	Btm	TD Date
SURFACE	12.25	14	1065	11/14/1983
PRODUCTION	7.88	1051	7818	11/19/1983

TUBULARS	Tool Type	Joints	Size	Weight	Grade	Thread	Top D	Bottom D
SURFACE CASING	Casing	25	9.63	36.00	J-55	LTC	14	1051
PRODUCTION CASING	Casing	194	5.50	17.00	J-55	STC	14	7773
	Float Collar	1	5.50				7773	7774
	Casing	1	5.50	17.00	J-55	STC	7774	7816
	Casing Shoe	1	5.50				7816	7818
BRIDGE PLUG	Bridge Plug	1	5.50				7550	7551
BRIDGE PLUG	Cast Iron Bridge Plu		9.63				100	102

CEMENT JOBS	Stage	Sacks	Cement Jobs	Top D	Btm D	cbl
SURFACE CASING	1ST STAGE	500	LEAD G	14	1051	No
PRODUCTION CASING	1ST STAGE	750	LEAD MAXFILL	4956	7215	No
	1ST STAGE	200	TAIL 50/50 POZMIX	7215	7818	No
PRODUCTION CASING	ABANDONMENT PLUC	100	LEAD FRESH WATER	6350	7510	No
	ABANDONMENT PLUC	150	LEAD-2 FRESH WATER	4169	5441	No
PRODUCTION CASING	ABANDONMENT PLUC	250	LEAD FRESH WATER	450	1265	No
SURFACE CASING	ABANDONMENT PLUC	40	LEAD FRESH WATER	0	13	No

PERFORATIONS	Formation	Zone	Top	Btm	Date	Reason	Comments
	J SAND		7634	7672	02/03/1984	PRODUCTION	JET

Comments: