
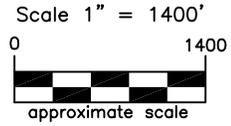


JR Land Surveying, LLC

8114 Northstar Drive
Windsor, Colorado 80528
P. 970-576-4641

WELL LOCATION CERTIFICATE

THIS MAP DOES NOT REPRESENT A BOUNDARY SURVEY

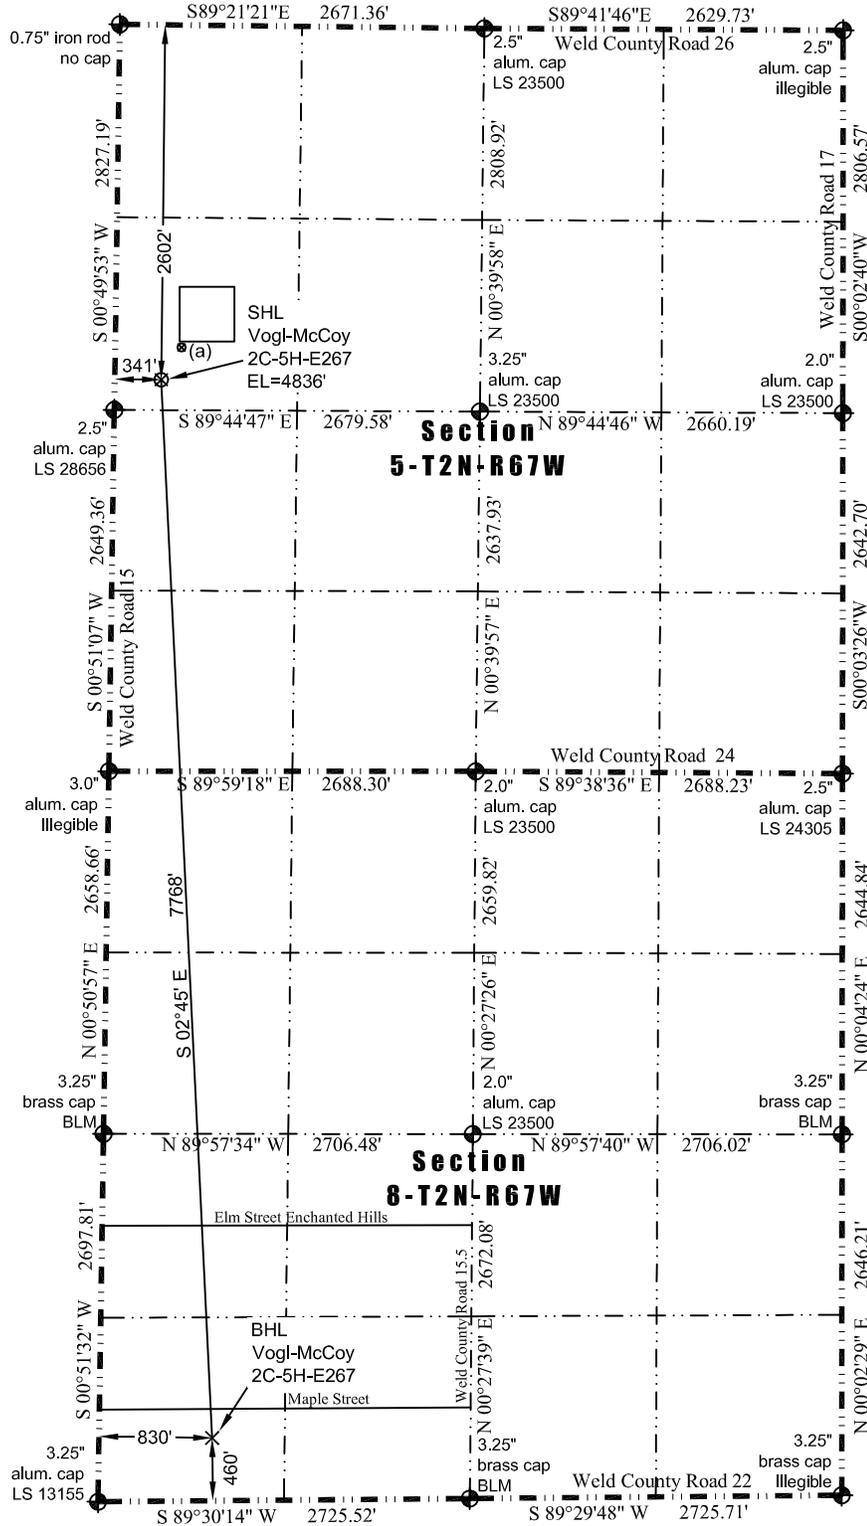

LEGEND
 ⊕ - found survey monument
 (c) - calculated dimension

In accordance with a request from Jay Knutson of EnCana Oil & Gas (USA) Inc., JR Land Surveying, LLC has determined the location of the **Vogl-McCoy 2C-5H-E267** well site to be SHL: 2602' FNL and 341' FWL, (BHL: 460' FSL and 830' FWL), as measured at ninety (90) degrees from the section lines of Sections 5 and 8, Township 2 North, Range 67 West of the 6th Principal Meridian, Weld County Colorado.

Nearest:
 Building: 586' southwest
 Above Ground Utility: 316' west
 Public Road: 336' west
 Railroad: 26,740' northwest
 Property Line: 223' south
 Well Window: SHL is 312' outside
 Existing Well: Vogl 5-5, 280' northeast

Proposed Surface Hole Data:
 Latitude: N 40.16819° (BHL: 40.14688°)
 Longitude: W 104.92229° (BHL: 104.92114°)
 PDOP: 2.2

(a) Existing Well Data:
 Vogl 5-5
 Latitude: N 40.16884°
 Longitude: W 104.92175°
 FNL: 2363'
 FWL: 486'
 ELEV: 4838'
 PDOP: 2.4

I hereby certify that this Well Location Certificate was prepared by me or under my direct supervision on 4/8/2013 for and on behalf of EnCana Oil & Gas (USA) Inc. That it is not a Land Survey Plat or an Improvement Survey Plat and that it is not to be relied upon for establishment of fences, buildings, or other future improvement lines.



- Notes:**
- 1) Bearings and distances based on NAD 83 Colorado North State Plane Coordinate, using RTK GPS observations taken 4/3/13 by operator John Rice.
 - 2) Conversion factor to ground (1.000271871).
 - 3) Elevations based on NAVD 88 GPS heights and Geoid 2003 corrections.
 - 4) See Location Drawing for visible improvements within 500 feet of Pad Site.
 - 5) The surface use is a cultivated field.

NOTICE: According to Colorado law you must commence any legal action based upon any defect in this W.L.C. within three years after you first discover such defect. In no event may any action based upon any defect in this W.L.C. be commenced more than ten years from this said date of the certification shown hereon.

John Robert McGehee, LS#38219
 Well: Vogl-McCoy 2C-5H-E267 WLC