


CURRENT WELLBORE DIAGRAM
STATE OF COLORADO #2
Pronghorn Operating LLC (#10422)

C SW SW, Sec. 16-13S-44W 6PM

API #: 05-017-06098
Cheyenne Cty, CO

Drilled & Abandoned by Mull Drilling in 1970
8/01/1970 Spud
8/20/1970 TD
8/20/1970 Plugged & Abandoned

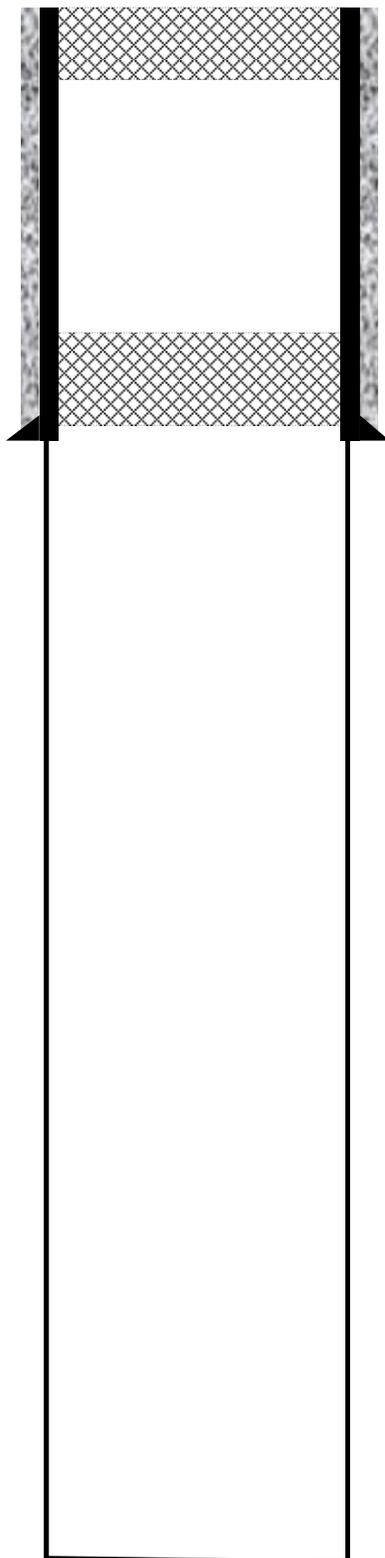

10 SK Cement Plug 0'-40' 8/20/1970

8-5/8" 20# csg @ 284'
Cmt to surface w/ 211 sx

20 SK Cement Plug 200'-300' 8/20/1970

7-7/8" Hole @5522' TD

PROPOSED WELLBORE DIAGRAM

STATE OF COLORADO #2

Pronghorn Operating LLC (#10422)


C SW SW, Sec. 16-13S-44W 6PM

API #: 05-017-06098

Cheyenne Cty, CO

Re-Entry Objective: Drill out original wellbore to TD, run & cement 5.5" casing, test Mississippian formation

8-5/8" 20# csg @ 284'
Cmt to surface w/ 211 sx

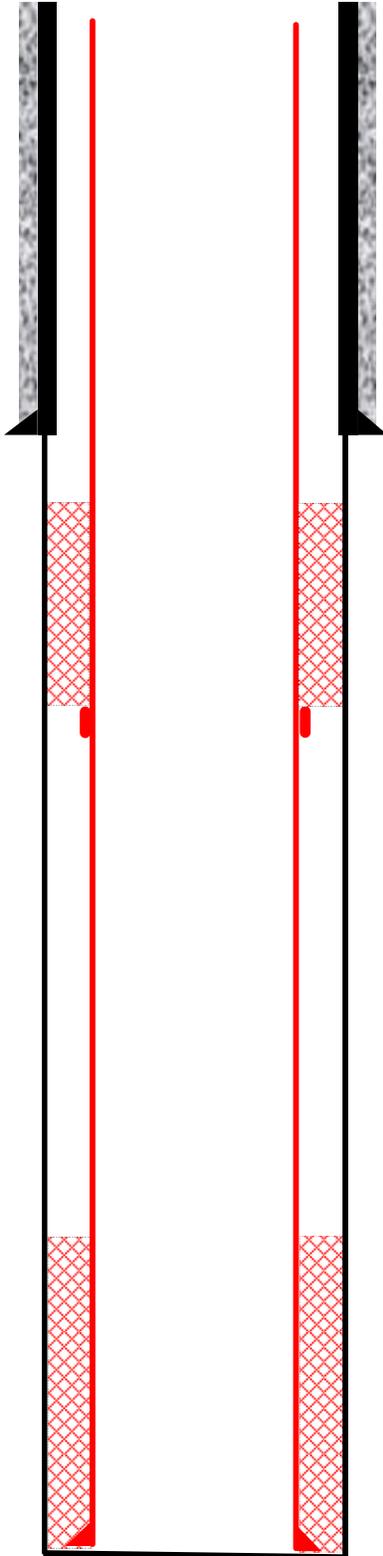

Stage Tool: *TBD per APD stage cement requirements

Est TOC 4022'

7-7/8" Hole @5522' TD

5.5" 15# casing @ 5522' cemented with 200 sx CMT