Mountain Petroleum Corporation

P & A Wellbore Diagram -- 4/12/2013

Smith-Whomble 1-3 API #05-125-06162-00

NESW Sec. 3-T2S-R43W

Yuma County, Colorado

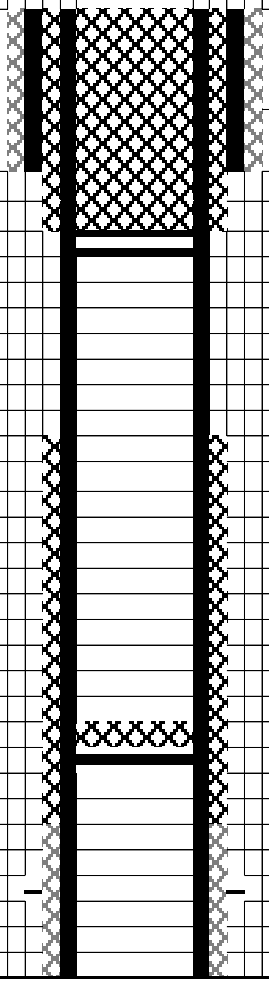

7" 23# Casing @160' (cemented to surface) . 1/12/1978

Shoot 2 1/2" holes @ 300', circ 60 sx cement to surface (4/12/13)

CIBP set @ 310' (4/3/13)

Top of cement @ 750' per CBL (4/3/13)

2 sacks cement dumped on top of CIBP

CIBP set @ 1362' (4/3/13)

Perfs: 1688'-1702' Niobrara (2/1/1978)

4 1/2" 9.5 # casing @ 1,820' 1/14/1978

TD 6 1/4" hole @ 1,860' MD