


BILL BARRETT CORPORATION
LOCATION DRAWING DETAIL FOR

DUTCH LAKE #6-62-23-0857BH & #6-62-23-0758BH
ON EXISTING DUTCH LAKE #16-24H PAD
SECTION 24, T6N, R62W, 6th P.M.
NW 1/4 NW 1/4

FIGURE #5A

SCALE: 1" = 200'
DATE: 06-05-13
DRAWN BY: J.S.

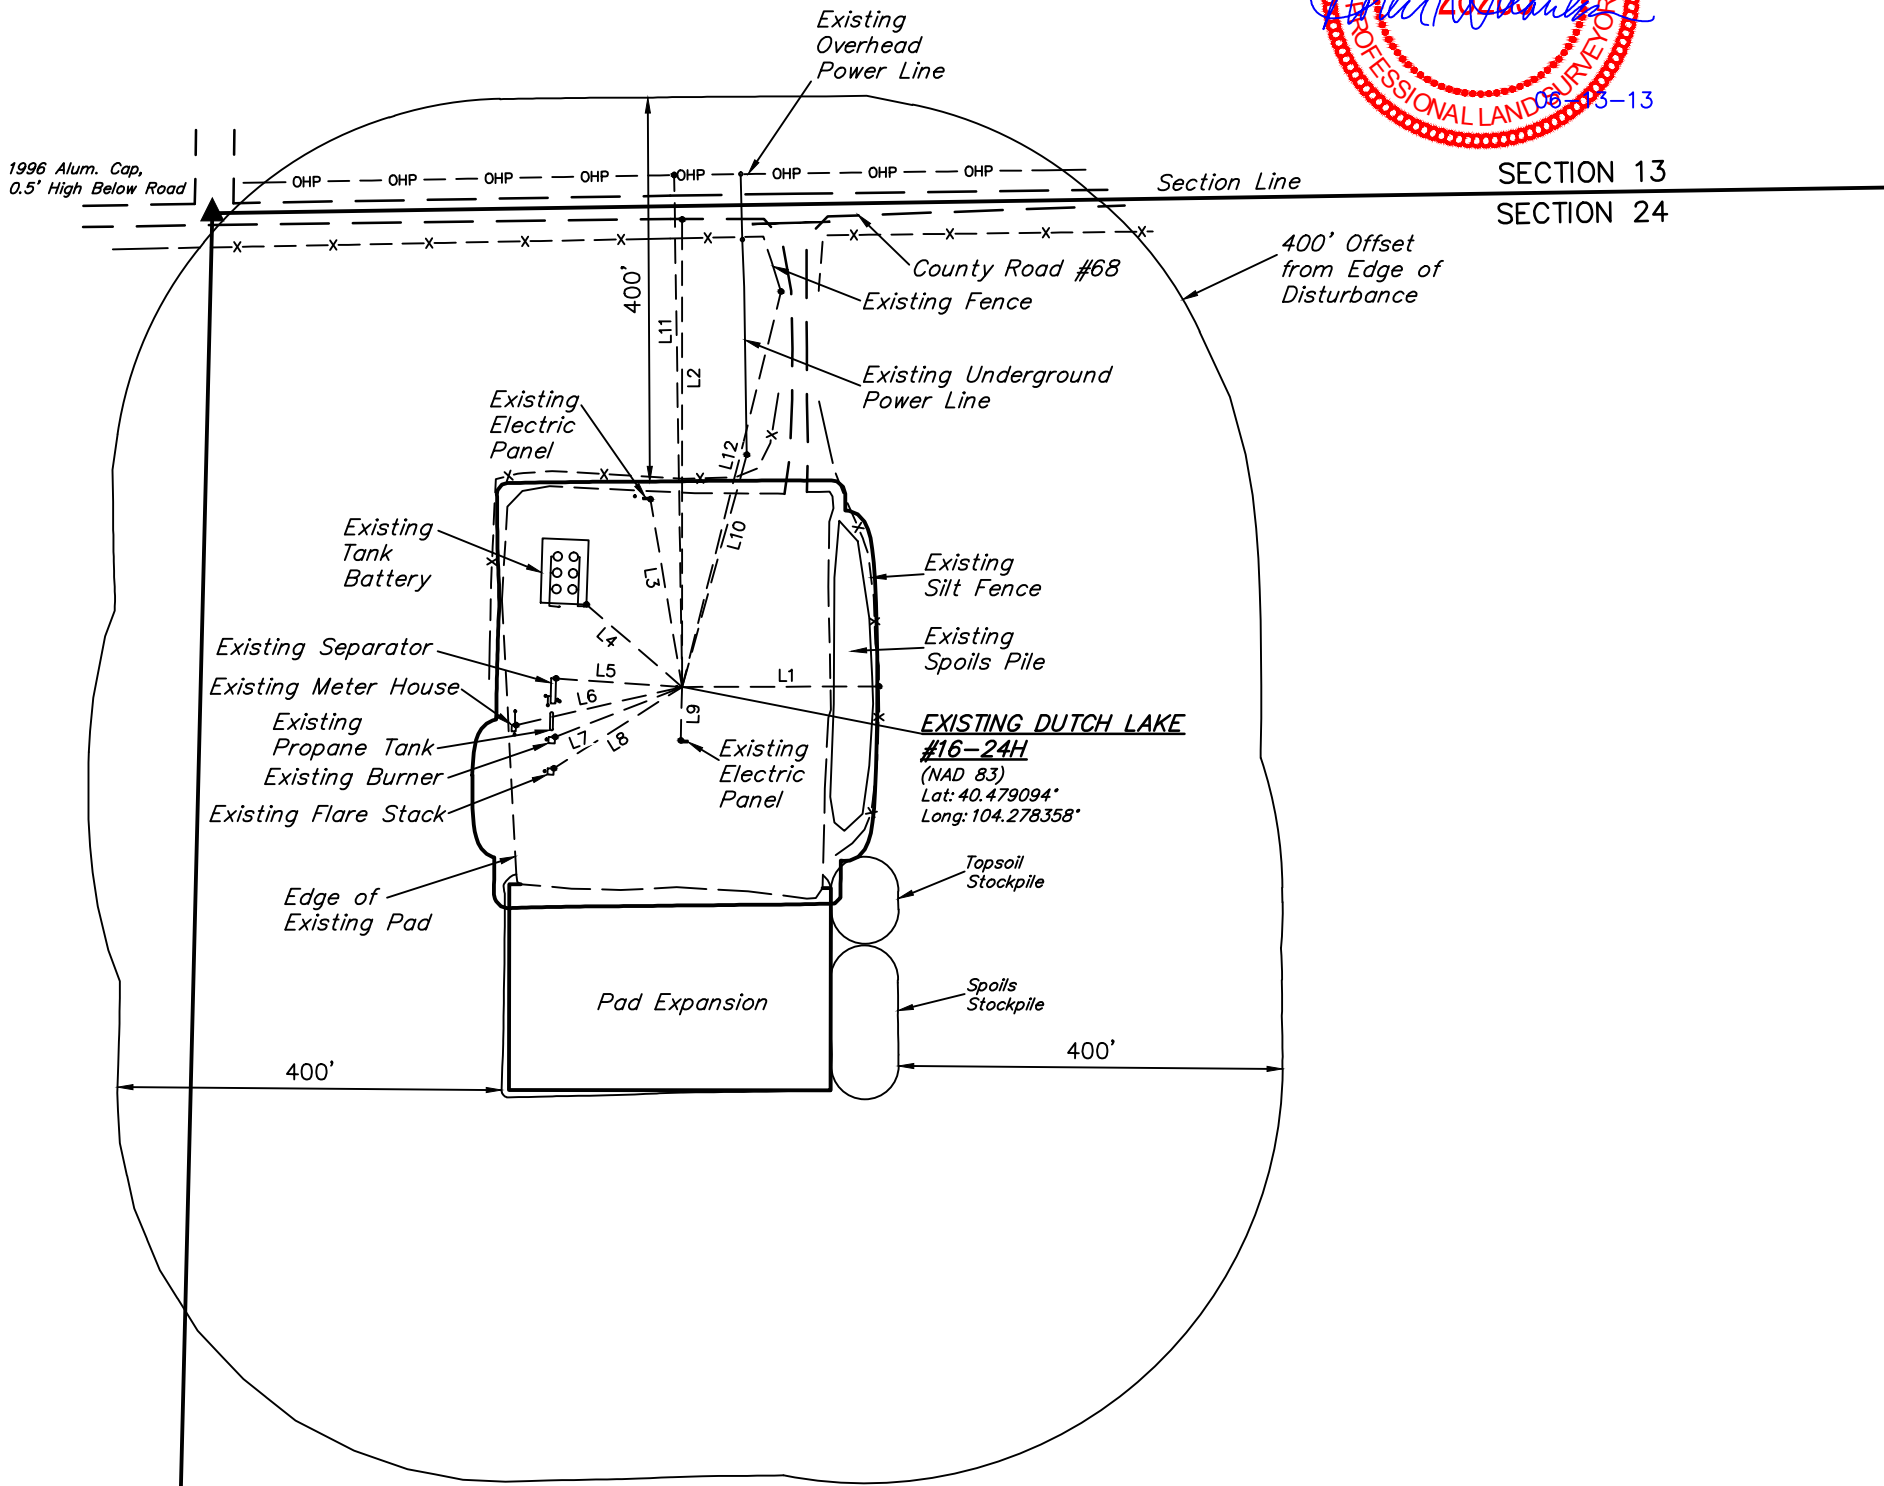

LINE TABLE		
LINE	DIRECTION	LENGTH
L1	EAST	205'
L2	NORTH	487'
L3	N10°W	198'
L4	N49°W	131'
L5	N86°W	132'
L6	S77°W	178'
L7	S68°W	142'
L8	S58°W	158'
L9	S02°W	56'
L10	N16°E	251'
L11	N01°W	533'
L12	N14°E	425'