


Jacobs Trust 1290 #6-32

Wellbore Diagram

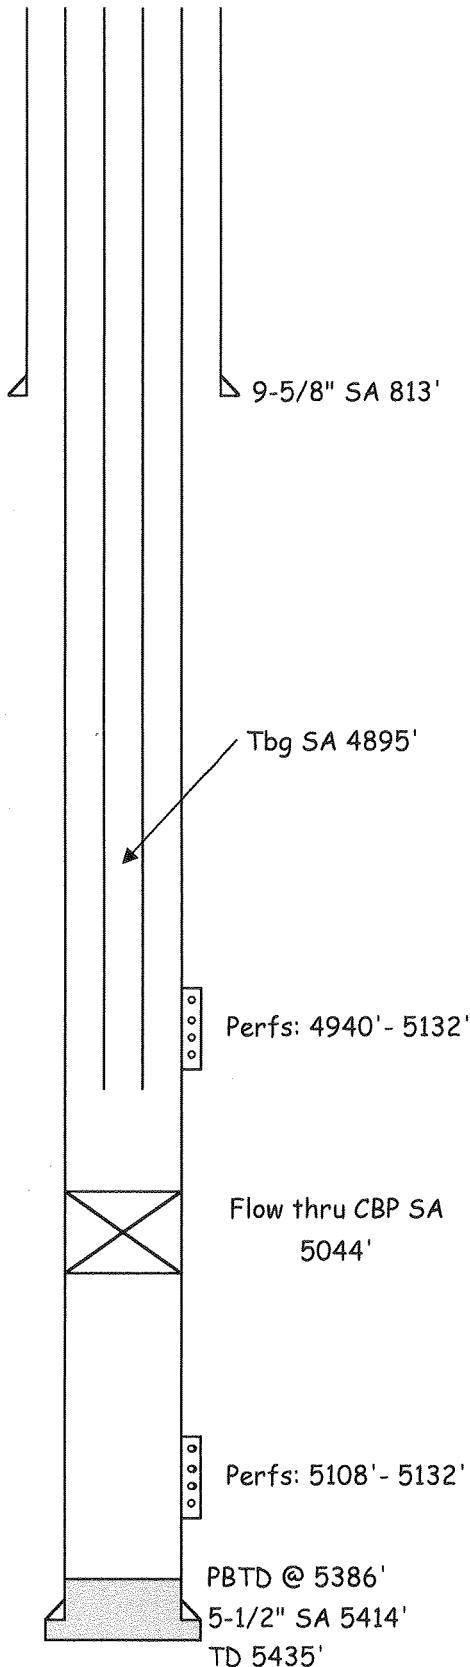

Well Name: Jacobs Trust 1290 #6-32

Operator: Gunnison Energy Corporation

Location: SWNE Sec 6-T12S-R90W

Gunnison County, Colorado

Spud Date: 09/10/07; Completion Date: 11/17/11

Completion Zone: Cozzette & Corcorin

Elevations: 8075' GL, 8086' KB

Casing & Tubing Details:

Size	Wt	Grade	Interval	Cement (sx)	TOC	Hole Size
9-5/8"	##	J-55	0-813'	112 + 106 + 79	Surf	12-1/4"
5-1/2"	17.0	N-80	0-5414'	215 + 382 + 25	Surf	7-7/8"

2-7/8" 6.5 N-80 0-4895'

Well History

9/10/07: Spud @ 0600. 9/24/07: Rig released @ 1530.

9/28/07 - 11/07/07: Drill out DV Tool @ 3531', run CBL from 5386' surface w/500 psi. Perf Corcorin 5108' - 32', 4 spf, 96 holes. Break down perfs w/1500 gals 4% HCl 6.5 bpm & 2124 psi. Set CIBP @ 5040' Perf Cozzette 4940' - 66', 4 spf, 104 holes. Break down perfs w/40 bbls 4% HCl 7 bpm & 3631 psi. Swab/flow. SI for winter

8/06/08 - 10/28/08: SITP 1500 psi. Hook up test separator & flow test well. SI well, locked all valves.

10/10/11-10/12/11: Pmpd 1000 gals 15% FE acid. Frac w/51.715 gals fluid and 85,000# 20-40 sd. MTP 6491#. Max rate 24.9 BPM ATP 4393#, avg rate 20.5 BPM. Pmpd 1010 bbls fluid, 91,200# 20-40 sd. MTP 3426#, max rate 27.5 BPM, ATP 2727#, avg rate 26.4 BPM. Set flw thru CBP @ 5044'.

10/13/11-11/14/11 Flw tested well

11/17/11 - SI well, locked all valves.

Formation Tops

Middle Sandstone 3816'

Cameo A 4217'

Rollins 4318'

Cozzette 4941'

Corcoran 5077'