


Well Name: KARCH BLUE D24-11

VERTICAL - ORIGINAL HOLE, 7/9/2013 11:37:46 AM

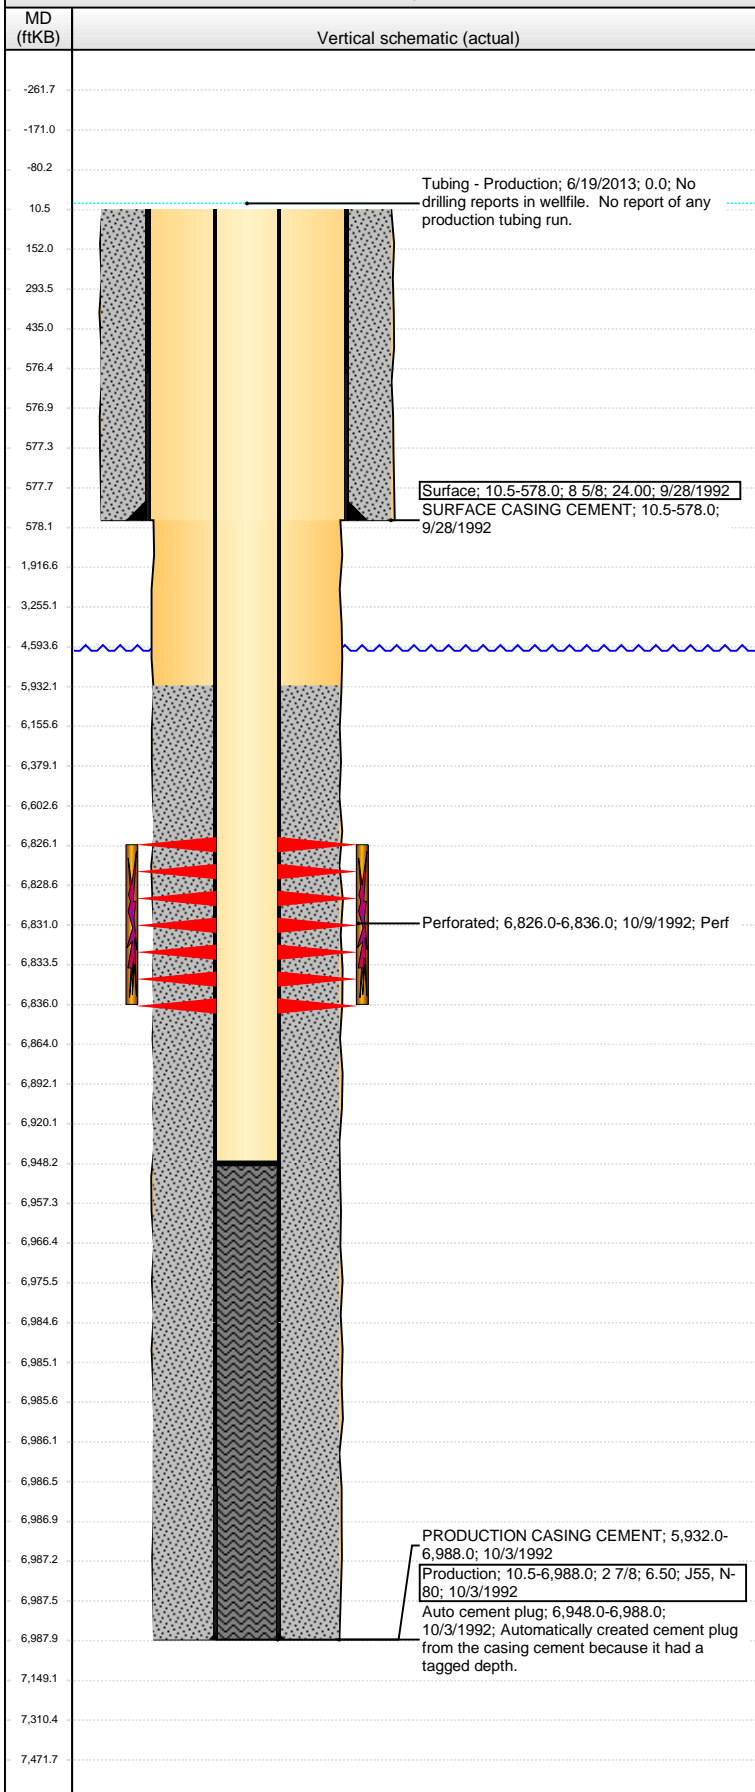

Well Header

API 05-123-16141	Business Unit WATTENBERG	District 15	Well Config VERTICAL
Original KB Elevation (ft) 4,759.50	KB - GL / MSL (ftKB)	Spud Date 9/28/1992	P & A Date

Comment

NO PRODUCTION TUBING FOUND IN WELL FILE

Directions To Well

Congressional Location

Quarter 1	Quarter 2	Quarter 3 NE	Quarter 4 SW	Section 24	Township 3 N	Twntshp N...	Range 64	Rng E/W Dir W
-----------	-----------	-----------------	-----------------	---------------	-----------------	--------------	-------------	------------------

Bottom Hole Location

North-South Distance (ft)	From N or S Line	East-West Distance (ft)	From E or W Line
---------------------------	------------------	-------------------------	------------------

Plug Back Total Depths

Date	Depth (ftKB)	Method	Com
10/7/1992	6,948.0	CASED HOLE LOG	

Wellbore Sections

Section Des	Size (in)	Act Top (ftKB)	Act Btm (ftKB)
SURFACE	12 1/4	10.5	578.0
PRODUCTION	7 7/8	578.0	6,988.0

Zone Statuses

Zone Name	Status Date	Status	Job
CODELL	11/4/1992	PR	DRILLING/COMPLETION - ORIGINAL, 9/28/1992 00:00

Casing Strings

Surface, 578.0ftKB

Casing Description	Run Date	OD (in)	Wt/Len (l...)	Grade	Top (ftKB)	MD (ftKB)
Surface	9/28/1992	8 5/8	24.00		10.5	578.0

Production, 6,988.0ftKB

Casing Description	Run Date	OD (in)	Wt/Len (l...)	Grade	Top (ftKB)	MD (ftKB)
Production	10/3/1992	2 7/8	6.50	N-80	10.5	6,988.0

Cement

Description	Top Depth (ftKB)	Bottom Depth (ftKB)
SURFACE CASING CEMENT	10.5	578.0
Description	Top Depth (ftKB)	Bottom Depth (ftKB)
PRODUCTION CASING CEMENT	5,932.0	6,988.0

Tubing Components

Item Des	OD (in)	Wt (lb/ft)	Grade	Jts	Len (ft)	Btm (ftKB)	Btm (TVD) (ftKB)
----------	---------	------------	-------	-----	----------	------------	------------------

Perforation Data

Zone	Bnch/St g	Entered Shot Total	Top (ftKB)	Btm (ftKB)	Date
CODELL, ORIGINAL HOLE		40	6,826.00	6,836.00	10/9/1992

Stimulations & Treatments

Date	Zone	Primary Job Type
10/9/1992	CODELL, ORIGINAL HOLE	DRILLING/COMPLETION - ORIGINAL
Technical Result	Tech Result Details	Tech Result Note

Comment

Other In Hole

Run Date	Des	OD (in)	Top (ftKB)	Btm (ftKB)
----------	-----	---------	------------	------------

Logs

Date	Type	Top (ftKB)	Btm (ftKB)
10/3/1992	COMPENSATED DENSITY	4,090.0	6,965.0
10/3/1992	INDUCTION	4,090.0	4,530.0
10/7/1992	CBL/CCL/GR	5,840.0	6,943.0