
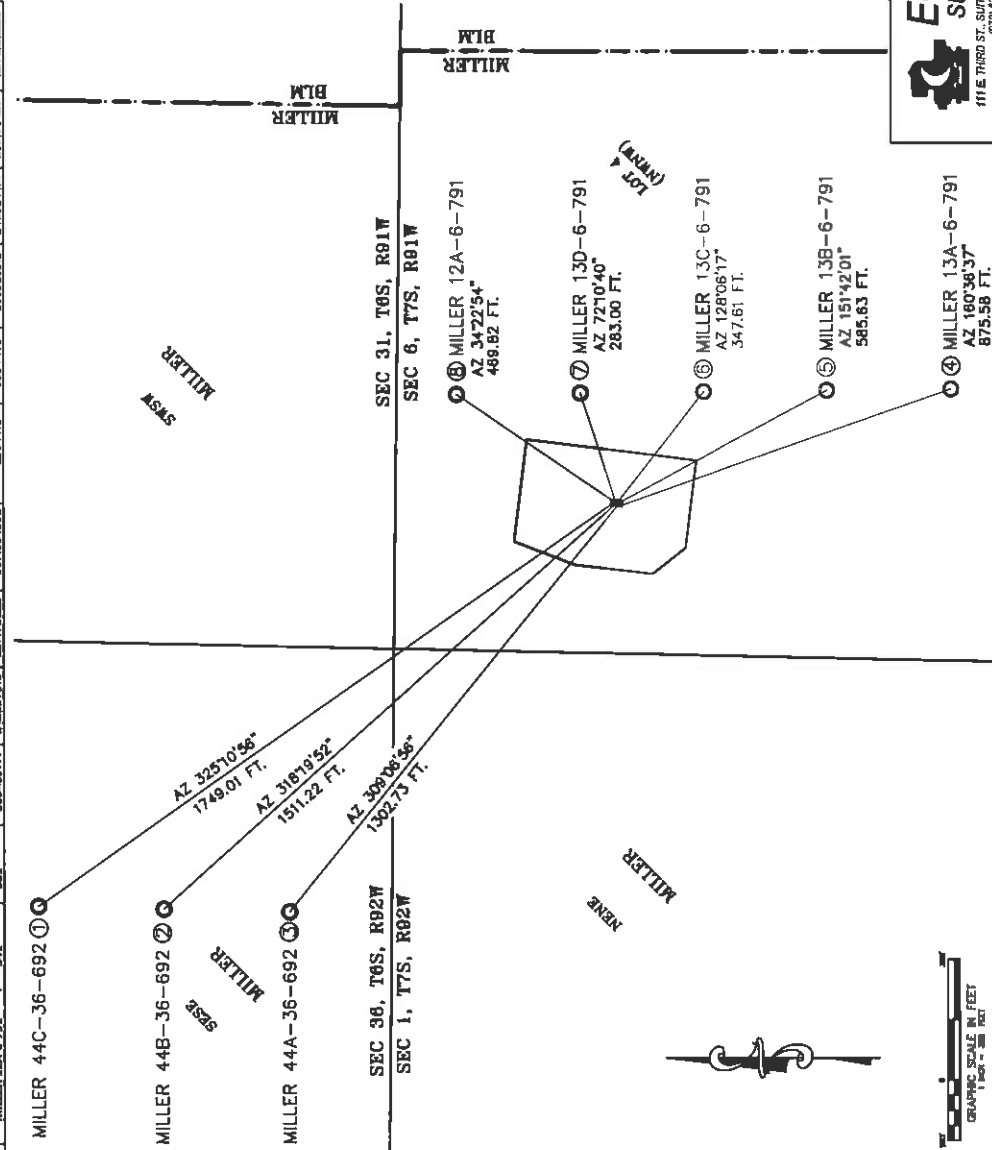


**MILLER PAD 9**  
**NAD 83 COLORADO CENTRAL ZONE**  
**SURFACE HOLE LOCATIONS**

SURFACE HOLE LOCATIONS			BOTTOM HOLE LOCATIONS		

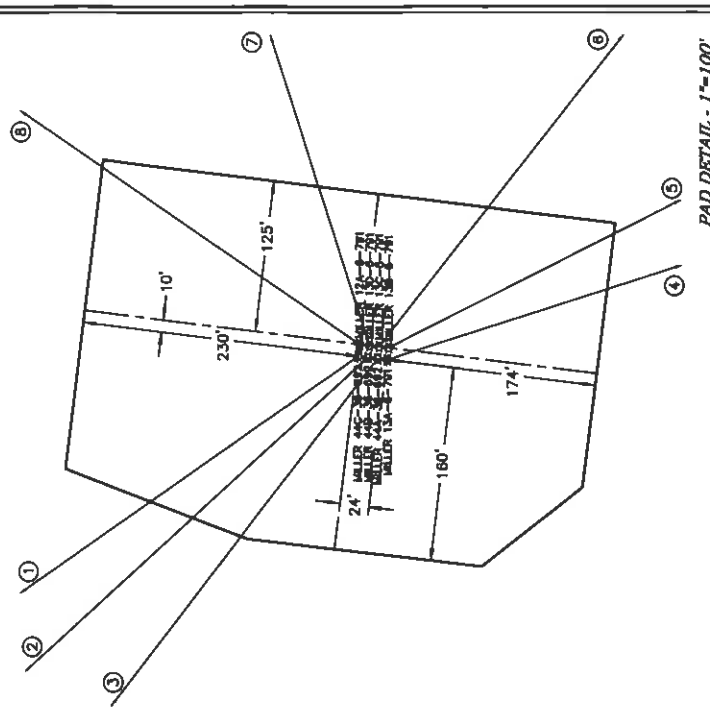

\*NOTE: THE FINISHED PAD ELEVATION IS 6090.8'

**ECLIPSE**  
surveying  
111 E. THIRD ST., SUITE 208, RIFLE, CO 81650  
(970) 825-3048

**Bill Barrett Corporation**

LOT 4, SECTION 6  
T. 7 S., R. 91 W. of the 6th. P.M.  
GARFIELD COUNTY, COLORADO

REV. DATE:	5/9/11
SCALE:	1" = 300'
DATE:	7/30/10
SHEET:	1 OF 1
PROJECT:	MILLER 9
DEPT:	TAR