

Well Name: Dragon Trail Unit 1022

API #: 05103070620000

Location: Sec. 19-2S-101W

KB: 6,236'


GL: 6,225'

County/St: Rio Blanco, CO

Created By: B. Hoyer

Date: 07/09/2013

Current Wellbore

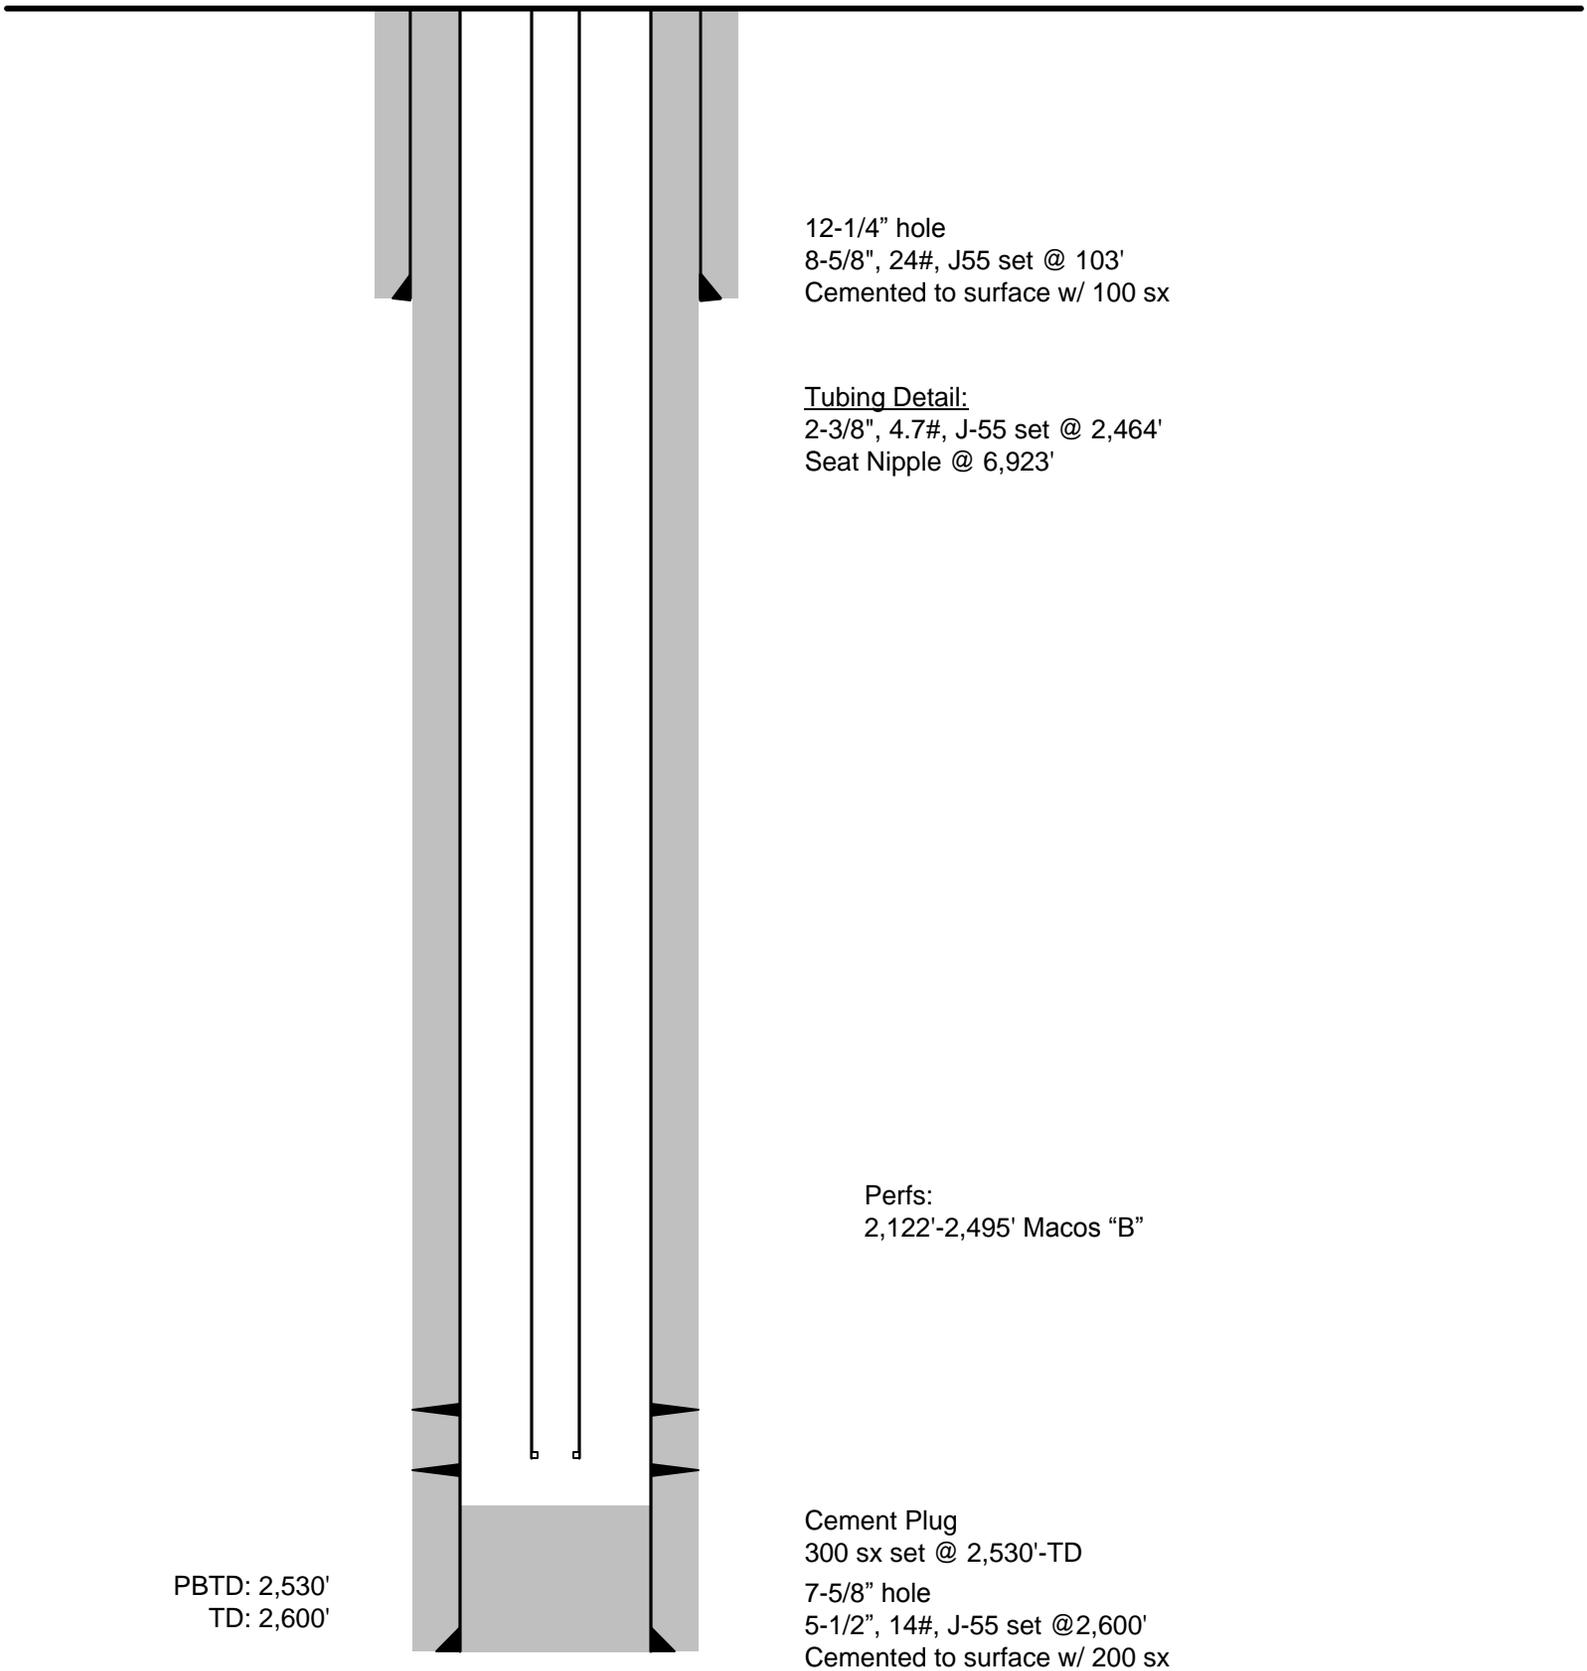

12-1/4" hole
8-5/8", 24#, J55 set @ 103'
Cemented to surface w/ 100 sx

Tubing Detail:
2-3/8", 4.7#, J-55 set @ 2,464'
Seat Nipple @ 6,923'

Perfs:
2,122'-2,495' Macos "B"

PBTD: 2,530'
TD: 2,600'

Cement Plug
300 sx set @ 2,530'-TD
7-5/8" hole
5-1/2", 14#, J-55 set @ 2,600'
Cemented to surface w/ 200 sx