

WPX Energy Rocky Mountain LLC

Diamond Elk, LLC PA 44-2

Parachute Field


SHL 2286' FSL 665' FWL (NW/4 SW/4) Section 1 T7S R95W 6th PM

BHL 996' FSL 558' FWL (SE/4 SE/4) Section 2 T7S R95W 6th PM

Garfield County Colorado

Formation Tops

(Measured Depths)

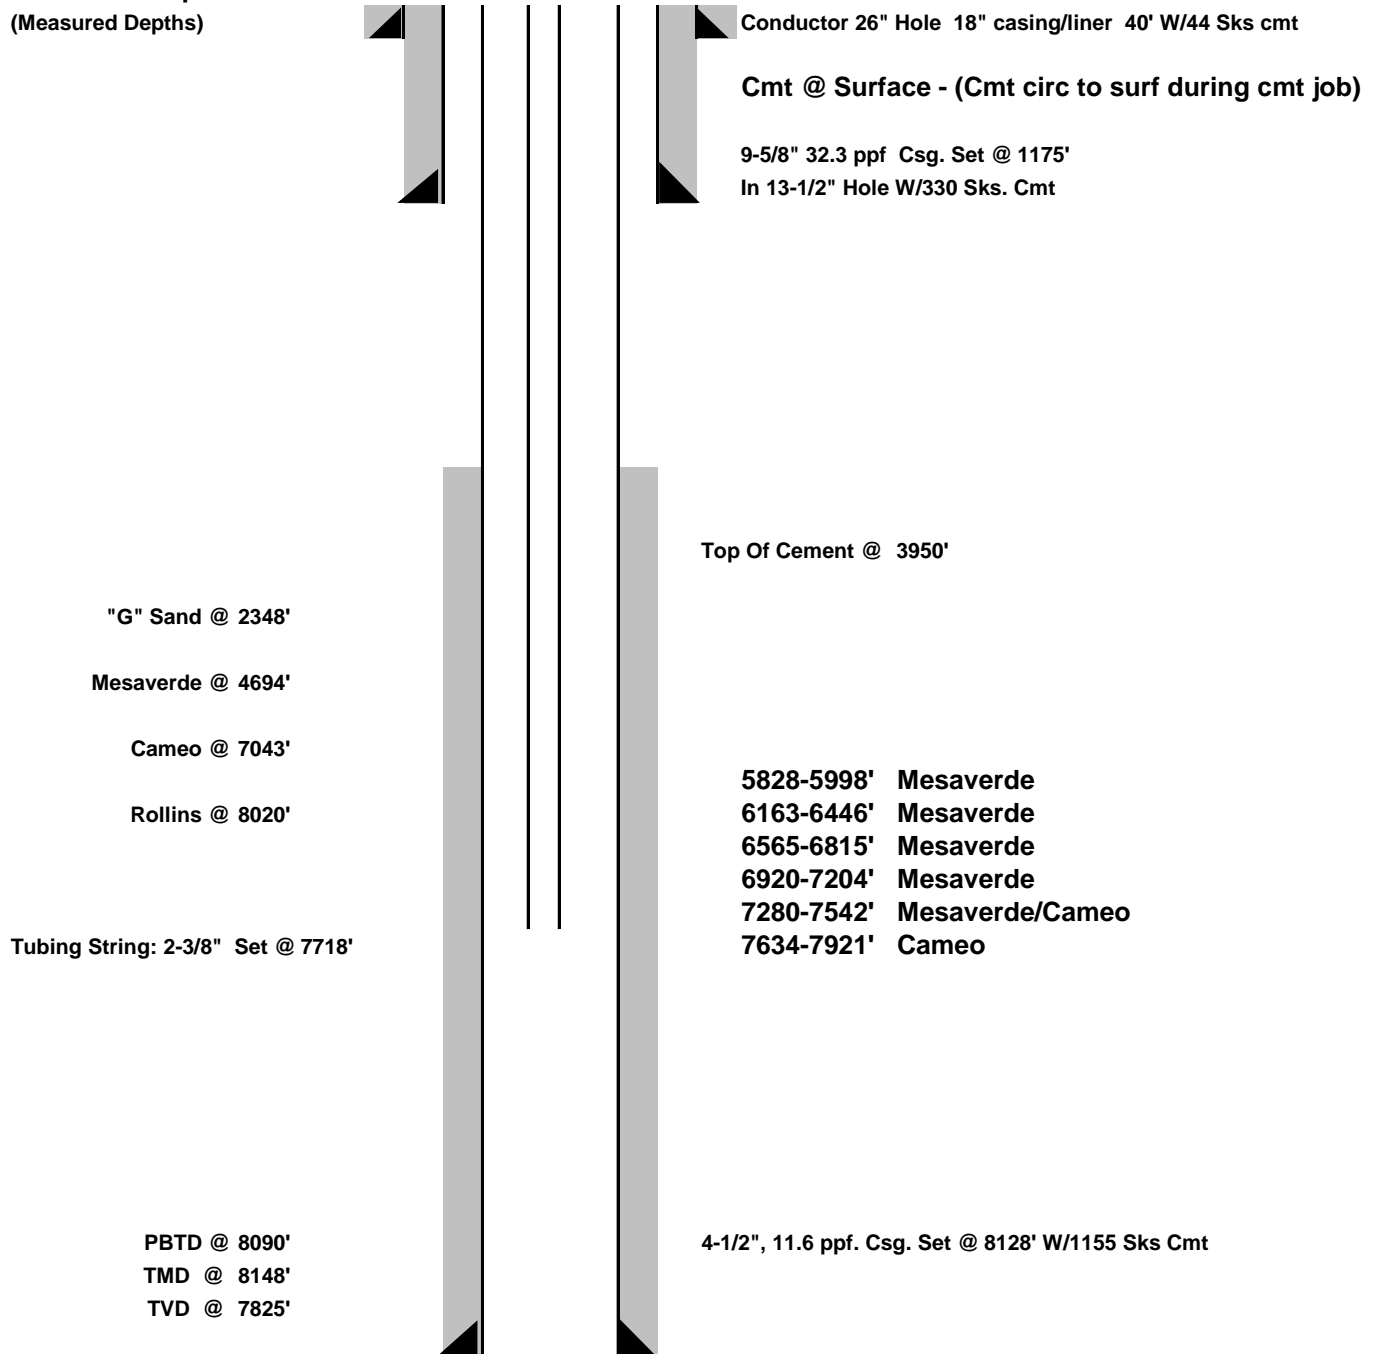

****NOTE: THIS IS NOT TO SCALE**