

Well

Operator

Location

County

State

Field

Footages

API

GL:4803'

Spud Date: 08-18-2006

TD Date: 08-26-2006

PARKER 2-0-33

EnCana Oil & Gas (USA) Inc.

NE NW Section 33-T3N-R67W, 6th P.M.

Weld

Colorado

Wattenberg

842' FNL & 1997' FWL

05-123-24113

KB:4818'

Log Tops

Sussex

4195'

Shannon

7001'

Niobrara

7080'

Codell

7344'

J Sand

7780'

Log TD

7952'

TOC @ 3550'

CIBP set @ 7410'
Drilled out 6-14-13
CFP set @ 7180'
Drilled out 6-14-13

TOC @ 6270'

Production Tubing

2-3/8" 4.7# J-55 tubing, set @ 7775'
Seat Nipple & Notched Collar

7935'


—

PBTD

7951'

—

Driller's TD

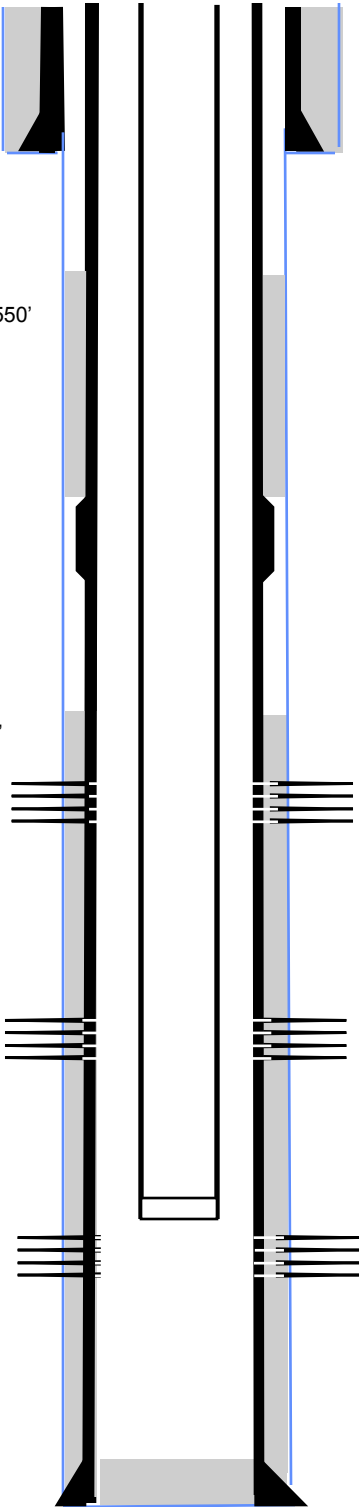

Surface Casing and Cement
8 5/8" , 24#, landed @ 555',cemented with 250 sxs

Production Casing and Cement
4-1/2", 11.6#, landed @7944',
cemented with 280 sxs

DV Tool
Set @ 5096', cemented above
DV tool with 340 sxs

7 7/8" Open Hole

Niobrara Frac 10/24/06
Perf'd 7124' – 7146', 7082' – 7092', 6 SPF
Frac'd with 179,972 gal SLF, 172,762# 20/40 sand

Refrac'd NB w/125,110 # sand and 49,306 gal frac fluid. 6-11-13

Codell Frac 10/24/06
Perf'd 7344' – 7366', 4 SPF
Frac'd with 98,266 gal SLF and 180,100# 20/40 sand

Refrac'd CD w/125,110 # sand and 42,842 gal frac fluid. 6-11-13

J Sand Frac 10/24/06
Perf'd J Sand 7780' – 7788', 7798' – 7826', 2 SPF
Frac'd with 170,436 gal SLF, 239,960# 20/40