



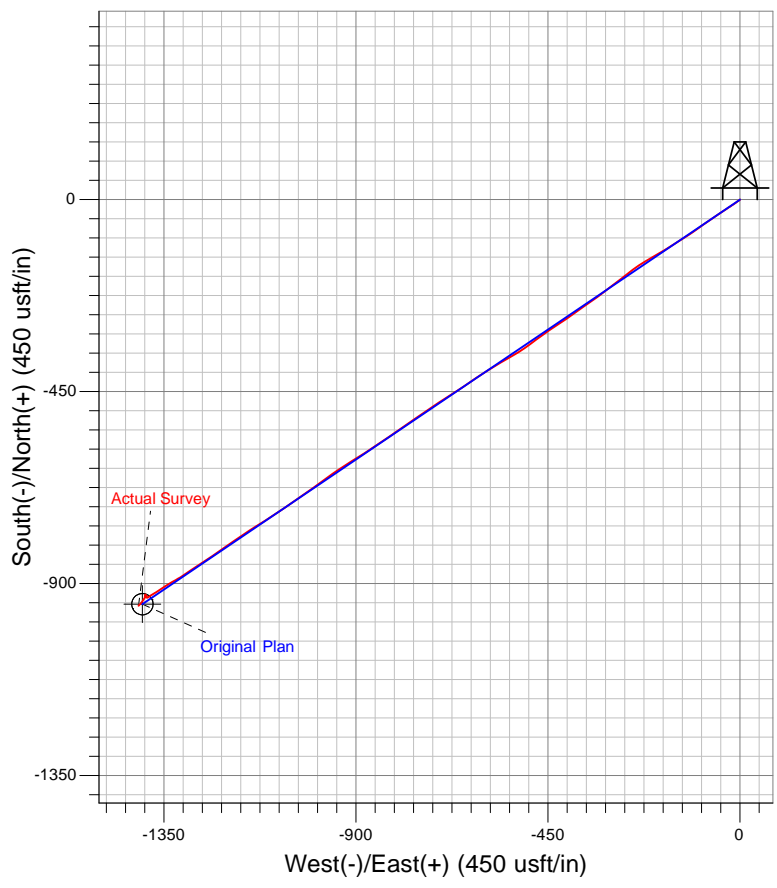

Well Name: PA 543-2
Surface Location: GV 84-1 Pad - West Cellar
North American Datum 1983 , US State Plane 1983 . Colorado Central Zone
Ground Elevation: 6027.00

+N/-S	+E/-W	Northing	Easting	Latitude	Longitude	Slot
0.00	0.00	1603974.00	2307263.10	39.46599	-107.95402	A6

KELLY BUSHING @ 6053.00usft (SSD 574 (26' RKB) jjb)

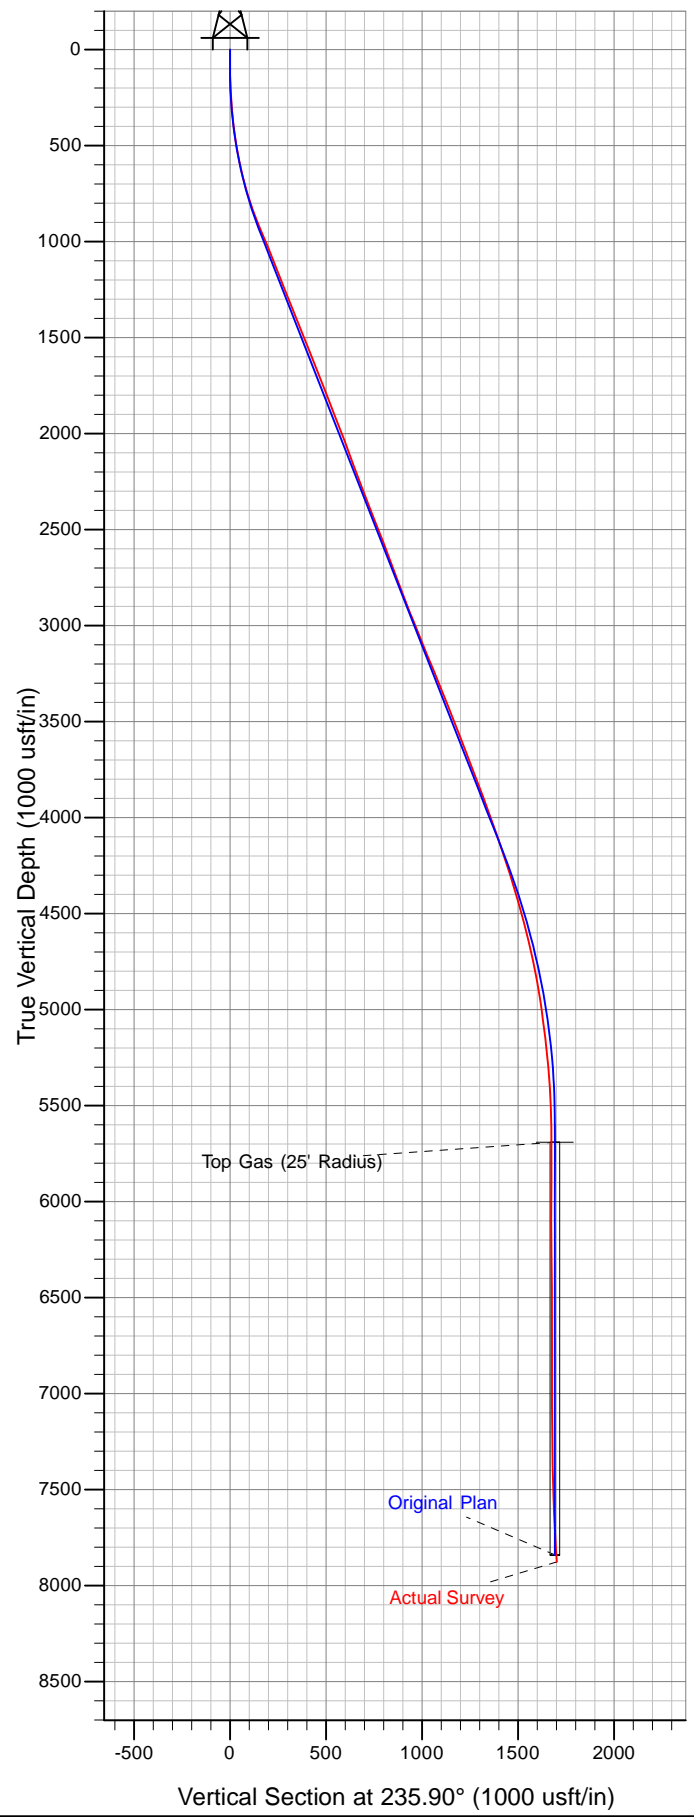

Azimuths to True North
Magnetic North: 10.11°

Magnetic Field
Strength: 52066.2snT
Dip Angle: 65.68°
Date: 3/1/2013
Model: IGRF2010