



Well Name: PA 334-2  
Surface Location: GV 84-1 Pad - West Cellar  
North American Datum 1983 , US State Plane 1983 . Colorado Central Zone  
Ground Elevation: 6027.00

+N/-S	+E/-W	Northing	Easting	Latitude	Longitude	Slot
0.00	0.00	1603972.10	2307250.70	39.46599	-107.95406	B5

KELLY BUSHING @ 6053.00usft (SSD 574 (26' RKB) jjb)

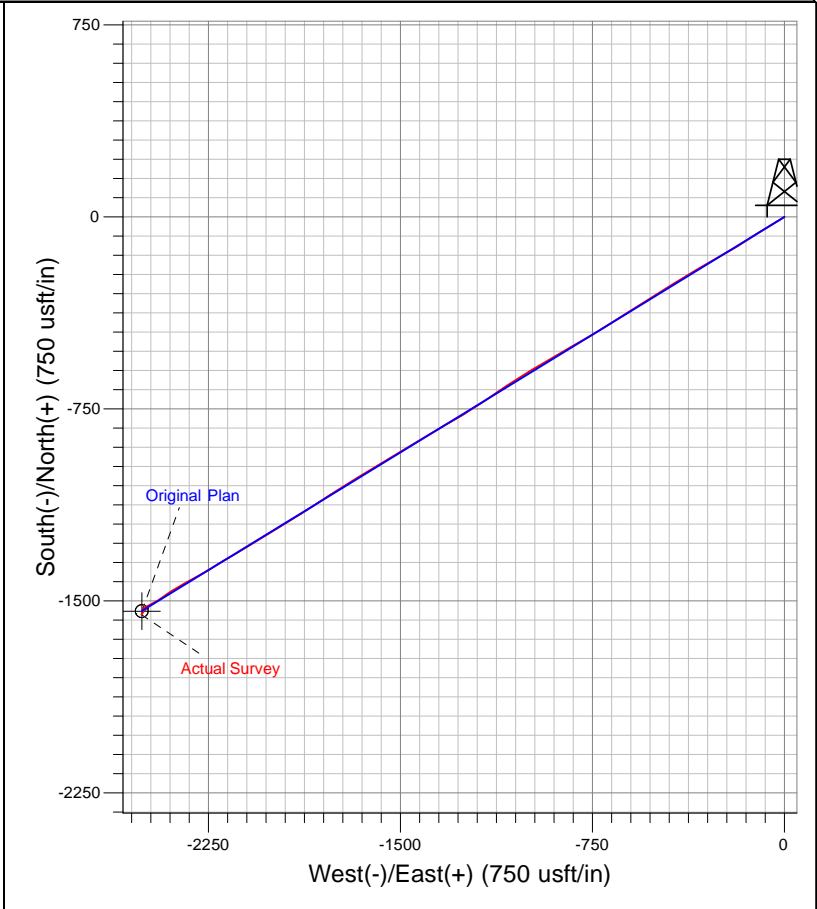
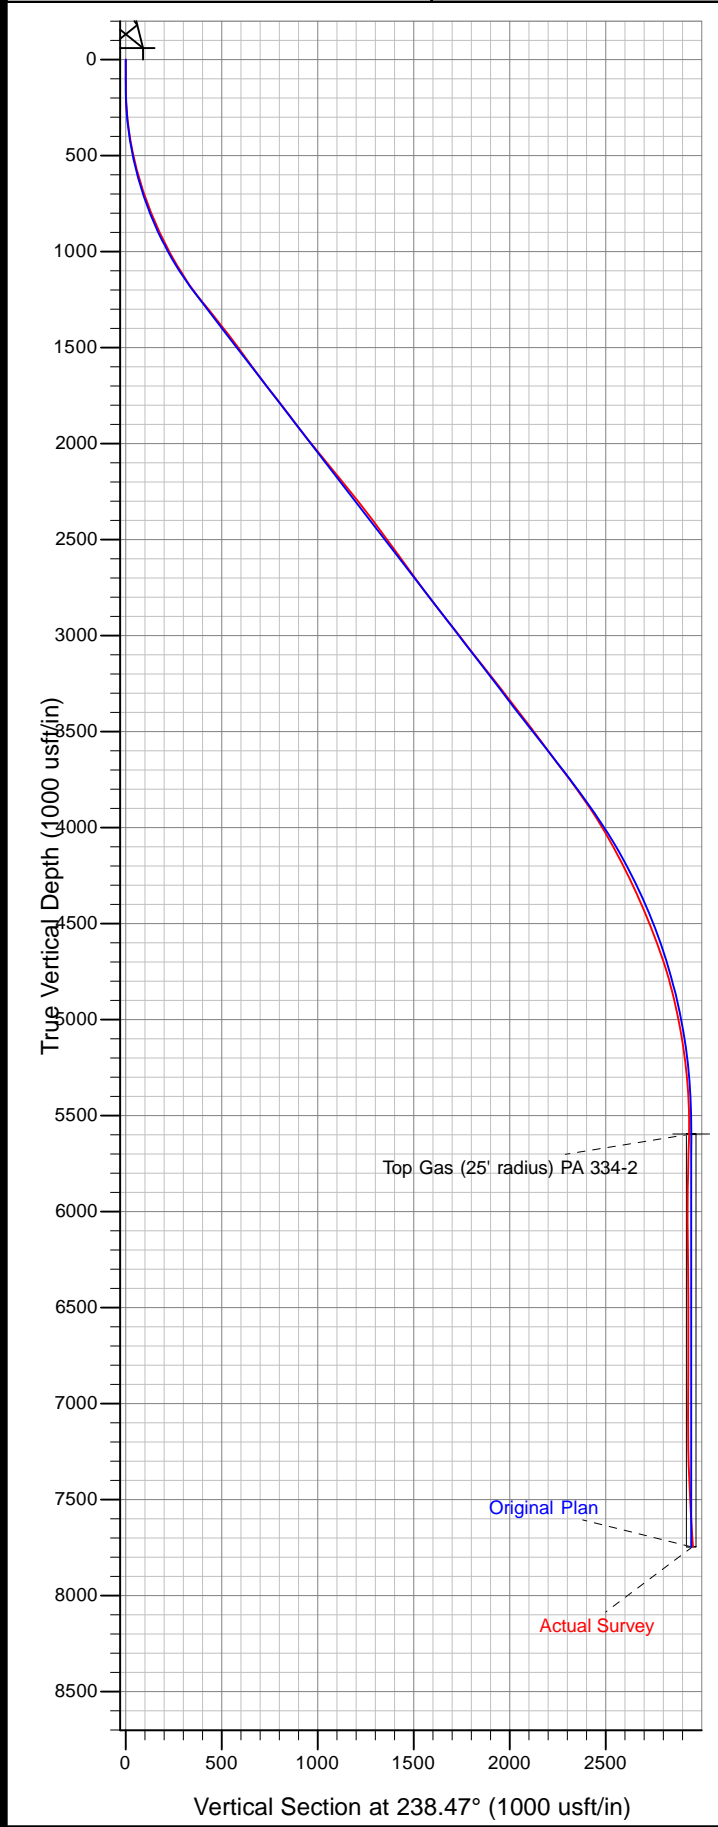


Diagram showing True North (T) and Magnetic North (M) directions. The angle between them is 10.12°.

Azimuths to True North  
Magnetic North: 10.12°

Magnetic Field  
Strength: 52071.7snT  
Dip Angle: 65.68°  
Date: 2/9/2013  
Model: IGRF2010