


WELL LOCATION CERTIFICATE: GREENLEAF 36C-15HZ

SECTION 15, TOWNSHIP 2 NORTH, RANGE 65 WEST, 6TH P.M.

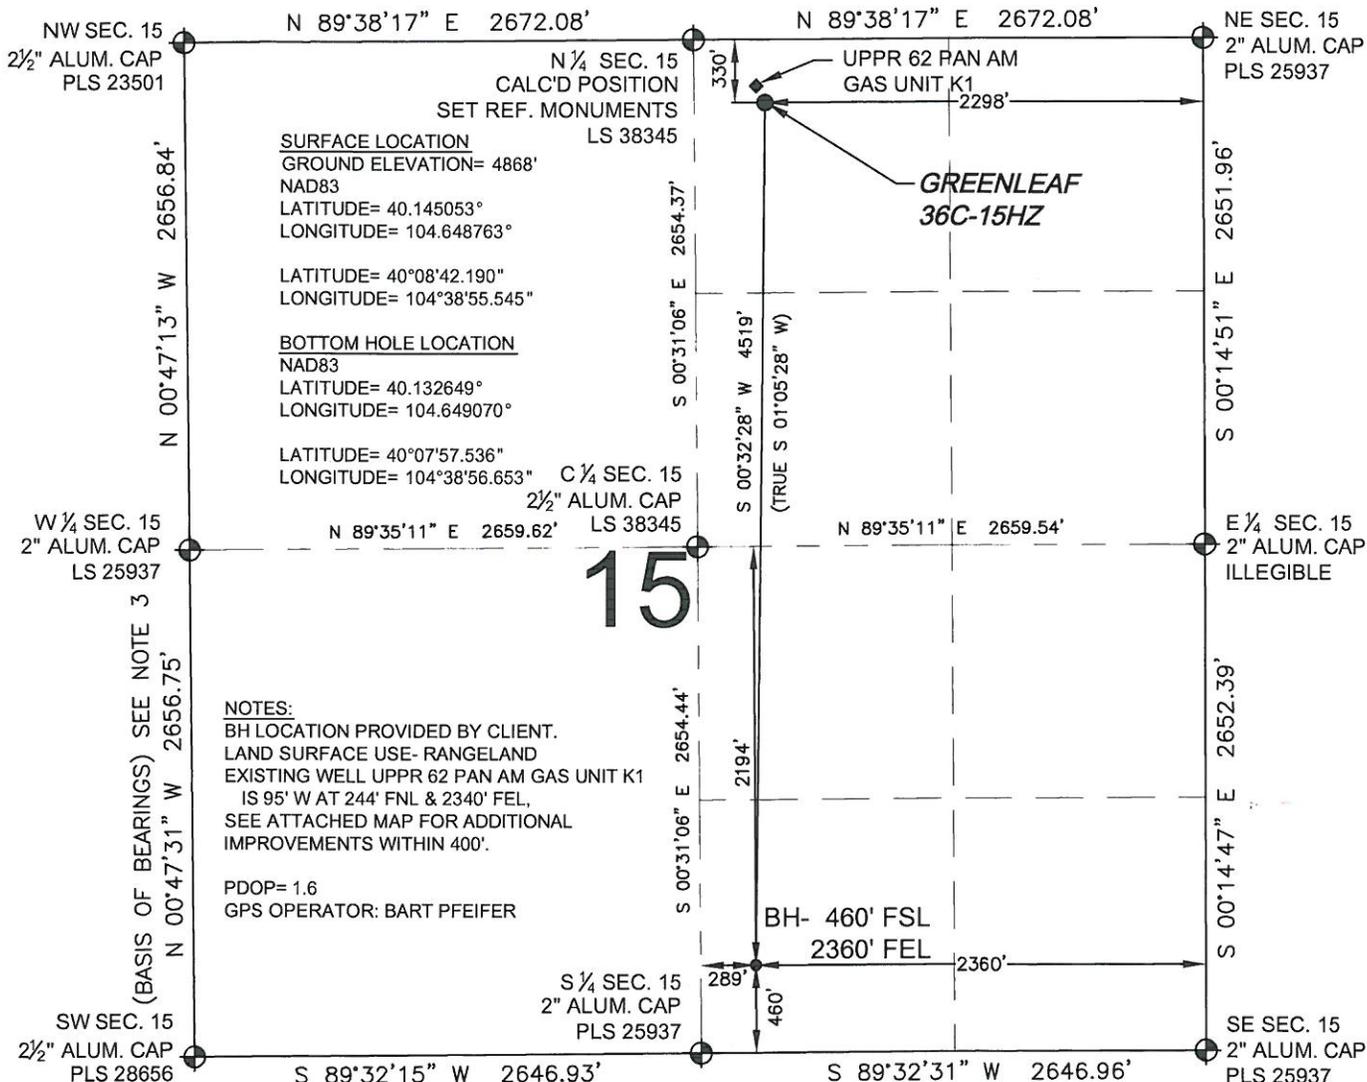

PREPARED BY: Petroleum Field Services, LLC 1801 W. 13th Ave. Denver, CO 80204	FIELD DATE: 05-19-12	SURFACE LOCATION:
	DRAWING DATE: 06-25-13	NW 1/4 NE 1/4, SEC. 15, T2N, R65W, 6TH P.M.
	BY: CLM	CHECKED: SMF
	WELD COUNTY, COLORADO	

