


WICKSTROM 18-1H PAD

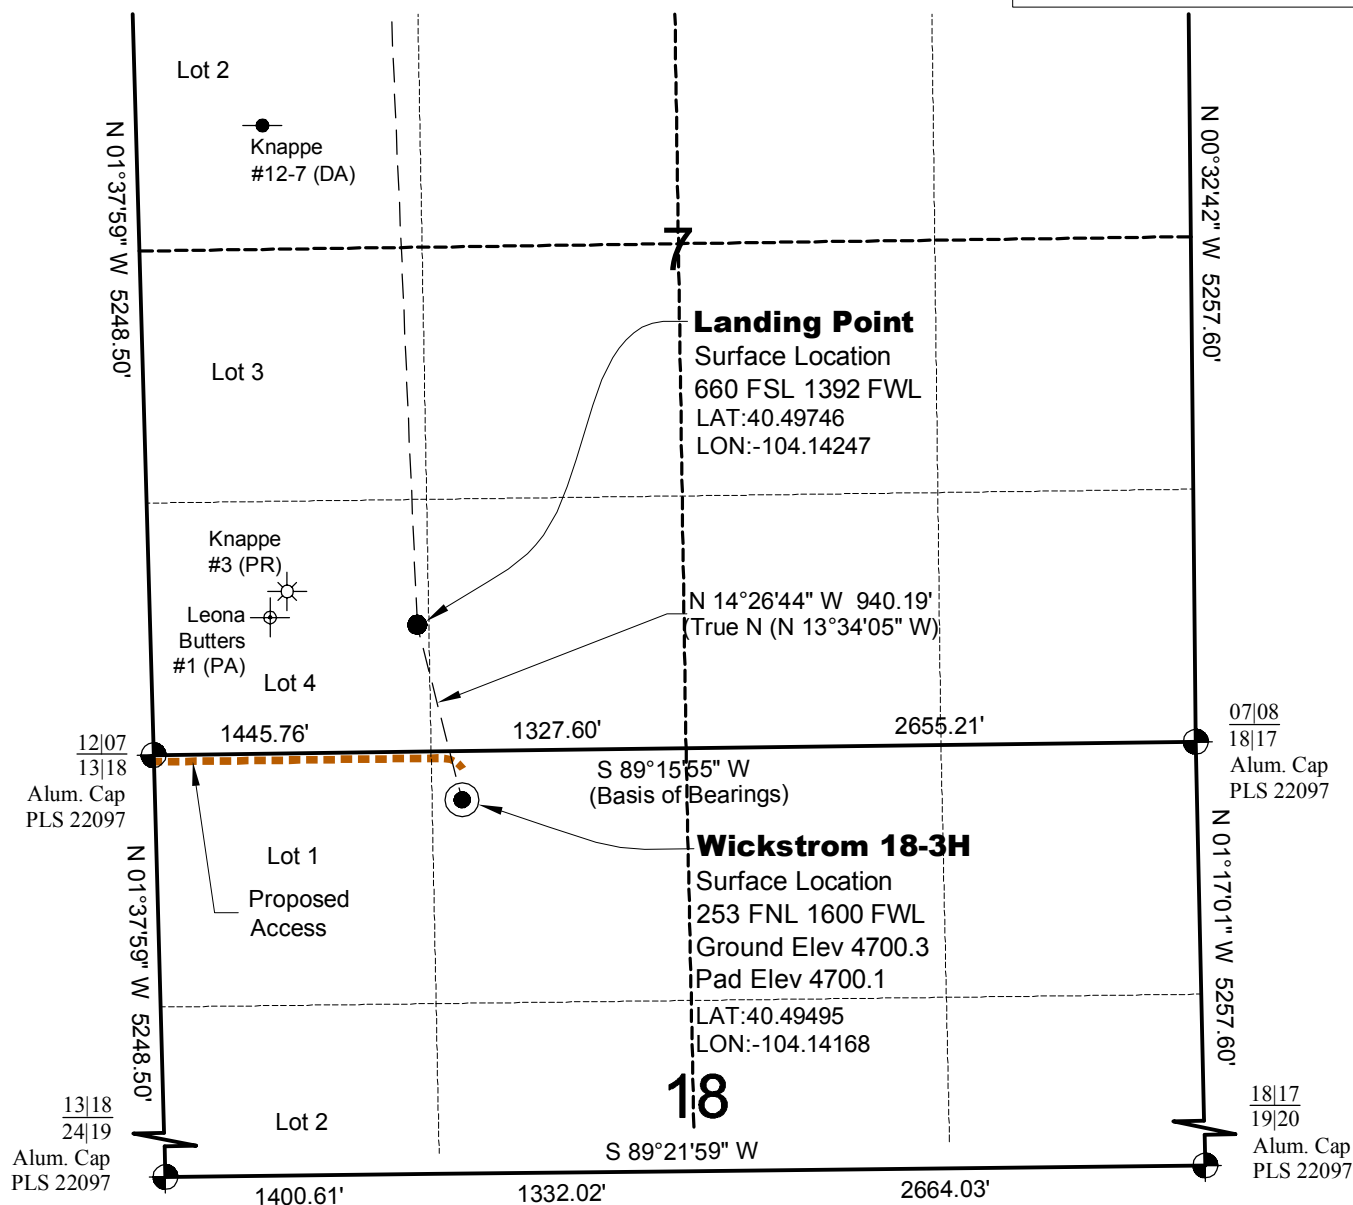


—●— Location Per COGCC. Not field located.

The undersigned hereby states that the well location shown hereon was staked on the ground based on existing monumentation and/or physical evidence found in the field and is correct to the best of my knowledge, information and belief.



North

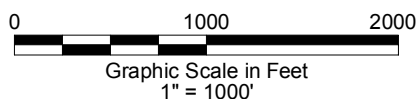

- 1.) Horizontal (NAD 83) and vertical (NAVD 88) datum is based on the Leica Geosystems SmartNet of Colorado.
- 2.) All directions, distances, and dimensions shown hereon are based on coordinates from the "Colorado coordinate system of 1983 north zone" (article 52 of title 38, C.R.S.).
- 3.) All section line dimensions shown hereon are based on field measurements of existing monuments and/or physical evidence found in the field unless otherwise indicated.
- 4.) Physical features shown hereon are for graphical representation only.
- 5.) See Form 2A for visible improvements within 400' of wellhead.
- 6.) Distances to nearest section lines are measured perpendicularly.
- 7.) This is not a land survey nor land survey plat.
- 8.) Date of Survey 2/14/13; Date of Drawing 7/24/13. REV 0

PDOP Reading: 2.1 Instrument Operator: Marc Woodard






LAND SURVEYING AND MAPPING
LAFAYETTE - WINTER PARK
Ph 303 666 0379 Fx 303 665 6320

CONDOR ENERGY TECHNOLOGY LLC
WICKSTROM 18-3H

SL NE1/4 NW1/4 SEC. 18 T6N R60W
HL TD LOT 4 SEC. 6 T6N R60W
6th PM MORGAN COUNTY COLORADO

HORIZONTAL LATERAL TD MAP

WICKSTROM 18-1H PAD

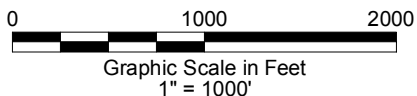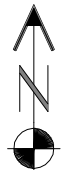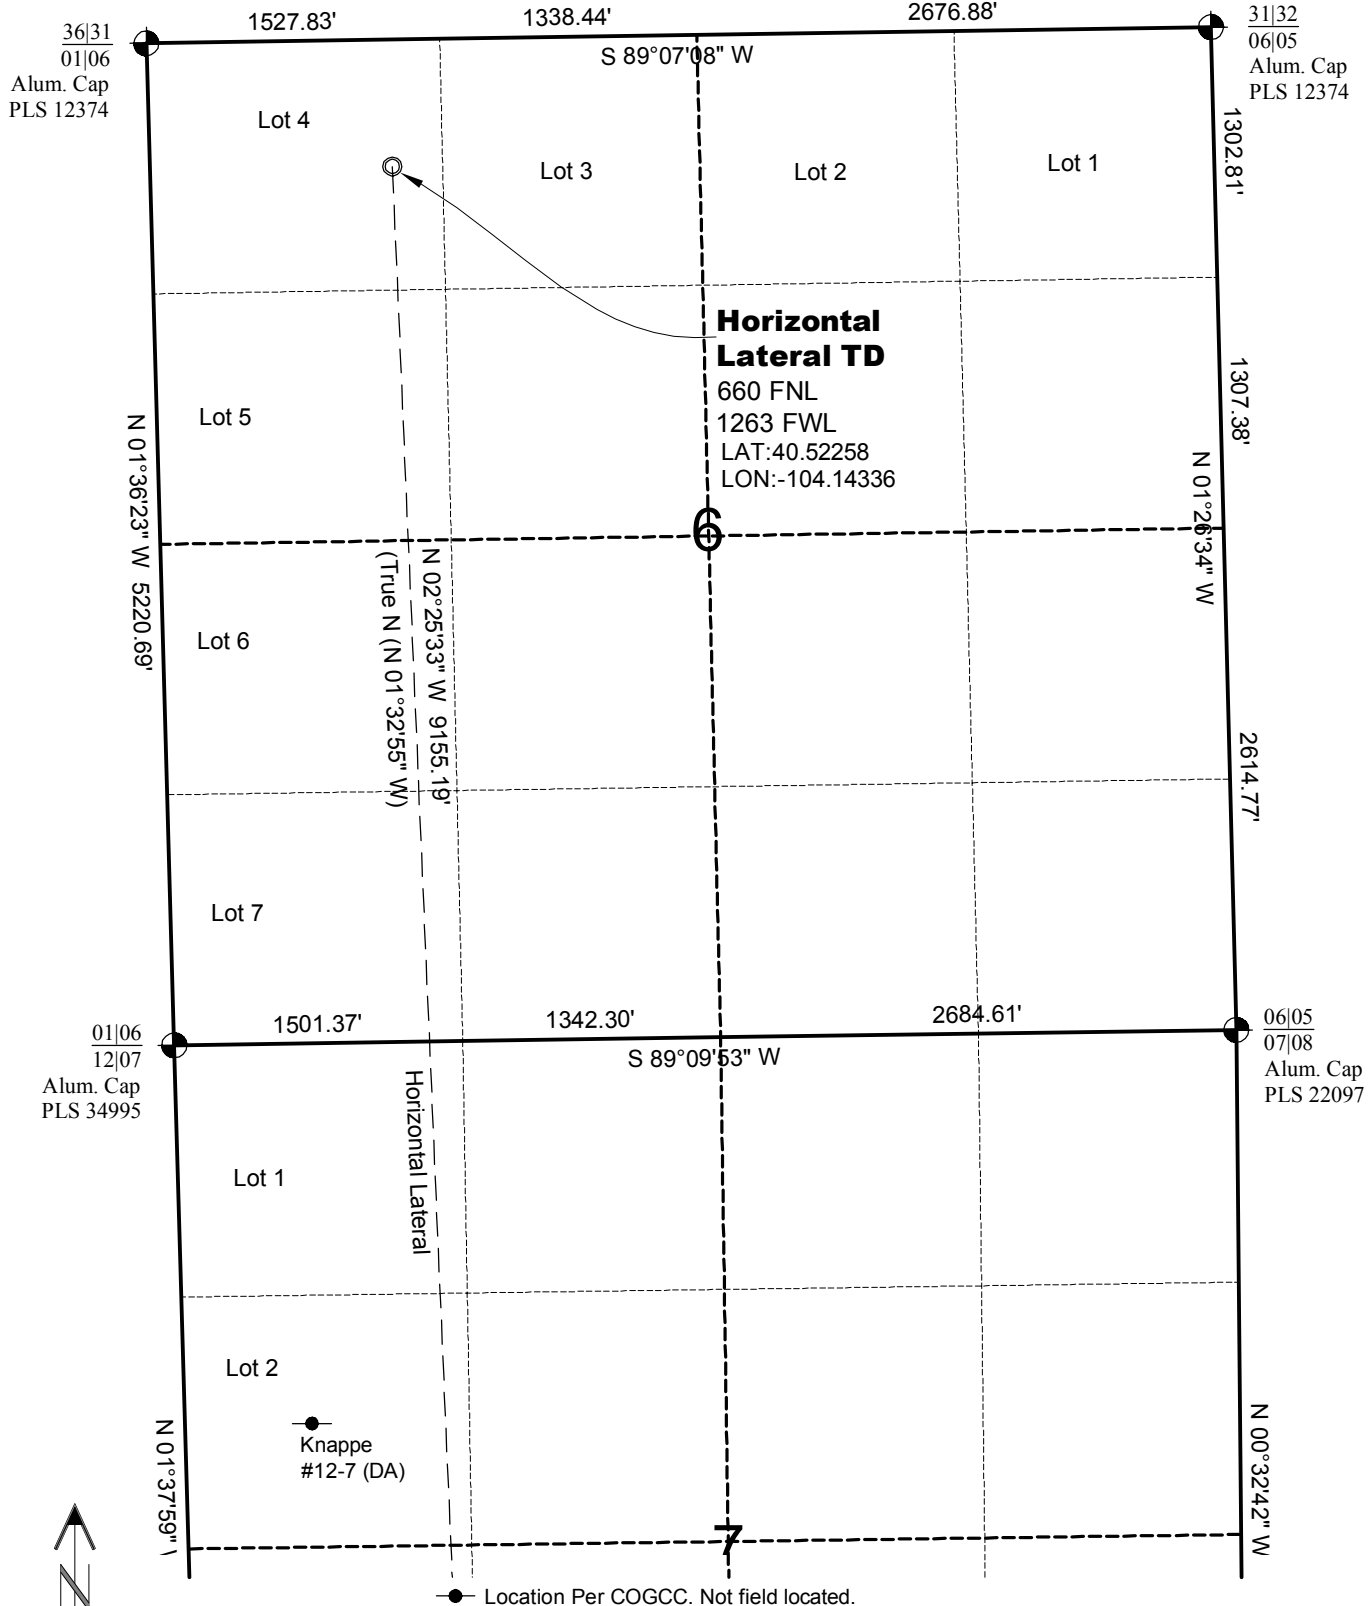

GEO SURV

LAND SURVEYING AND MAPPING
LAFAYETTE - WINTER PARK
Ph 303 666 0379 Fx 303 665 6320

CONDOR ENERGY TECHNOLOGY LLC
WICKSTROM 18-3H

SL NE1/4 NW1/4 SEC. 18 T6N R60W
HL TD LOT 4 SEC. 6 T6N R60W
6th PM MORGAN COUNTY COLORADO

DWG: G:\GEO SURV\Wickstrom\Wickstrom 18-1H\Wickstrom 18-1H.dwg USER: WTC DATE: Jul 24, 2013 9:35am