


WELL NAME: MOUSETRAP 36-11-66  
AS PLUGGED 5-9-12

SESE SEC 36 T11N R66W  
605 FSL & 605 FEL  
WELD CO, CO.  
API# 05-123-31826

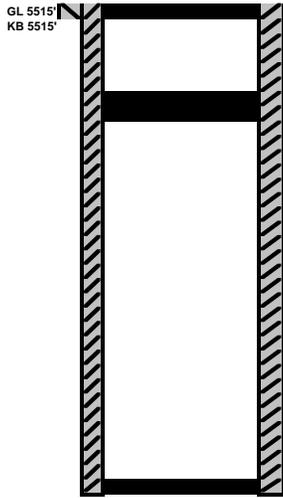

CUT OFF 4' BELOW GL  
PLUG #2 54-4' W/ 20 SXS CLASS G W/ 2% CC OPTIONAL

PLUG #1 @ 345-191' W/ 45 SXS CLASS G. WO CEMENT AND TAG @ 191'.

PBTB @ -1722'  
SURFACE 8 5/8" 36# K55 1763'

HOLE SIZE	PIPE SIZE	WEIGHT	GRADE	SACKS	SET DEPTH
12.25"	8 5/8"	36#	K55	665	1763'

P&A 5-9-12

NOTE: NOT TO SCALE

NOTE: SHOE JOINT NEVER DRILLED