


Lat40°, Inc. 1635 Foxtrail Drive, Suite 325 Loveland, CO 970-776-3321

ACCESS ROAD MAP

COPPERHEAD LD15-04

SECTION: 15
TOWNSHIP: 9N
RANGE: 58W

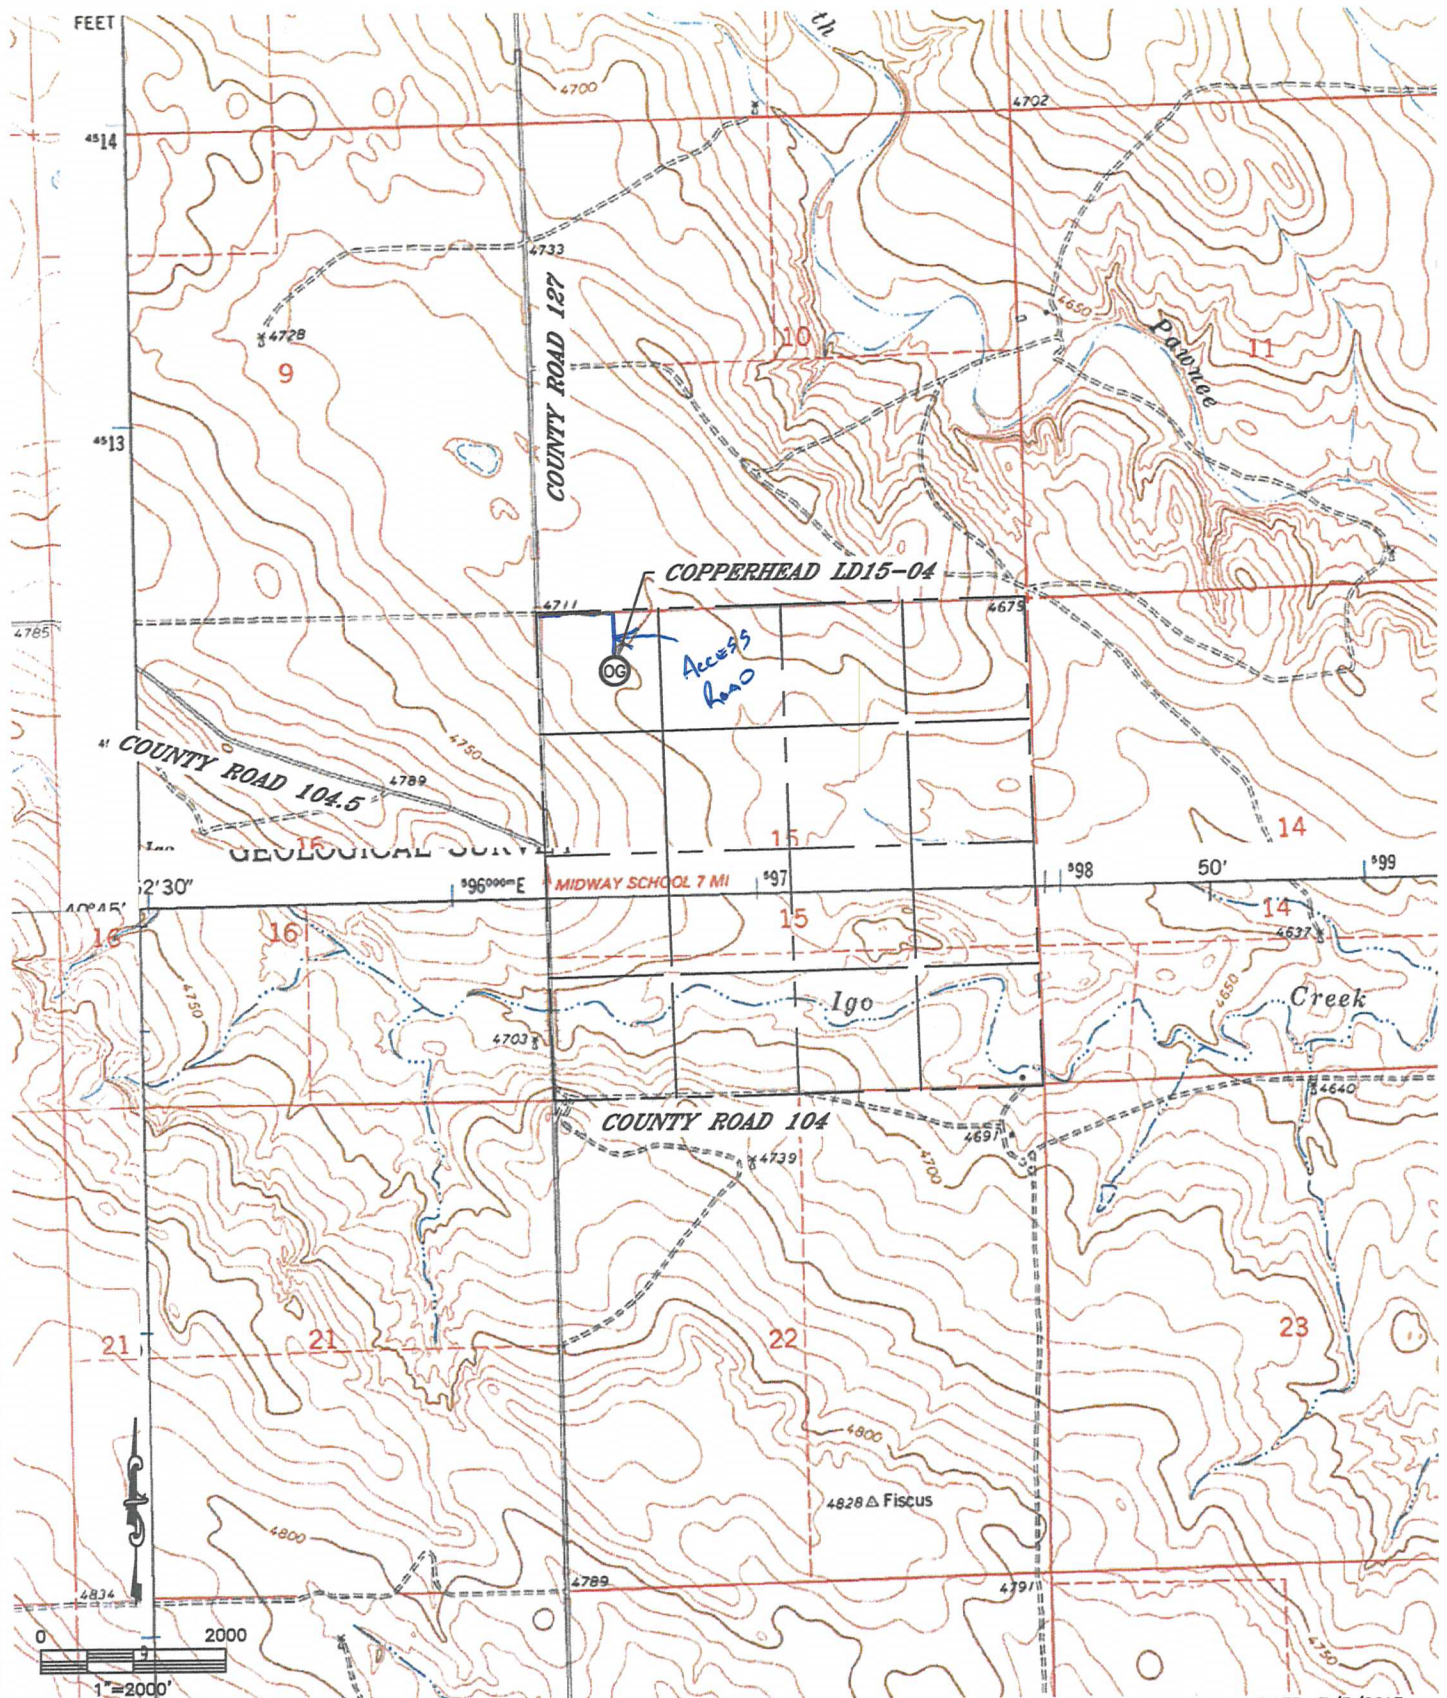

DATE: 7/3/2013
PROJECT#: 2013100