


JR Land Surveying, LLC

8114 Northstar Drive
Windsor, Colorado 80528
P. 970-576-4641

WELL LOCATION CERTIFICATE

THIS MAP DOES NOT REPRESENT A BOUNDARY SURVEY

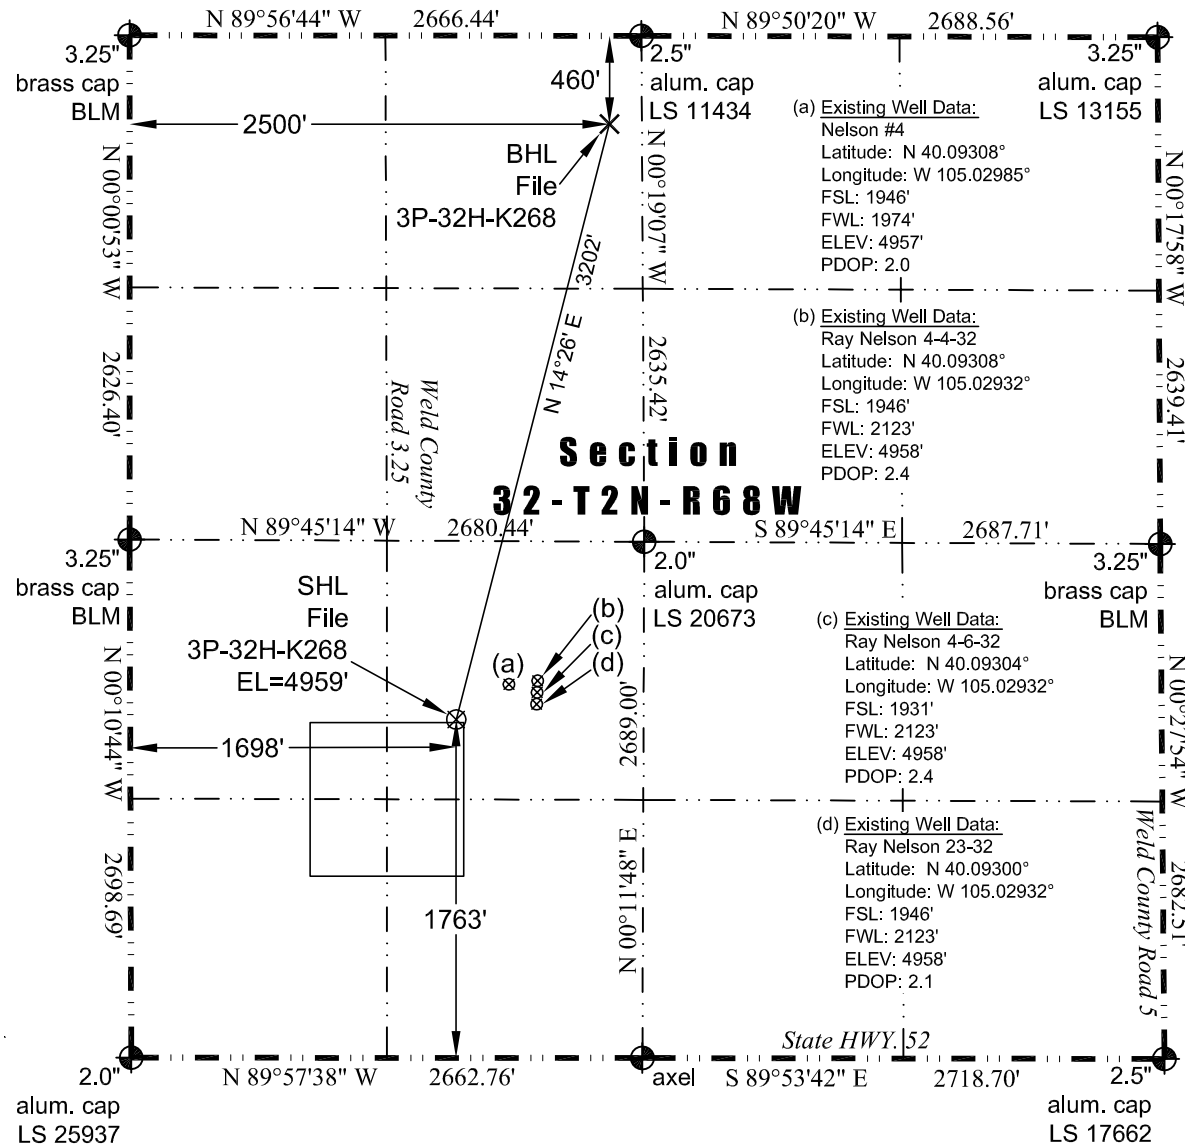

Scale 1" = 1000'
approximate scale

LEGEND
— found survey monument
— calculated dimension
(c)

I hereby certify that this Well Location Certificate was prepared by me or under my direct supervision on 7/5/2013 for and on behalf of EnCana Oil & Gas (USA) Inc. That it is not a Land Survey Plat or an Improvement Survey Plat and that it is not to be relied upon for establishment of fences, buildings, or other future improvement lines.

John Robert McGhee L.S.#38219
Well: File 3P-32H-K268 WLC