




Lat40°, Inc. 1635 Foxtrail Drive, Suite 325 Loveland, CO 970-776-3321

# WELL LOCATION CERTIFICATE


THIS MAP DOES NOT REPRESENT A BOUNDARY SURVEY

SECTION: 14  
TOWNSHIP: 6N  
RANGE: 67W

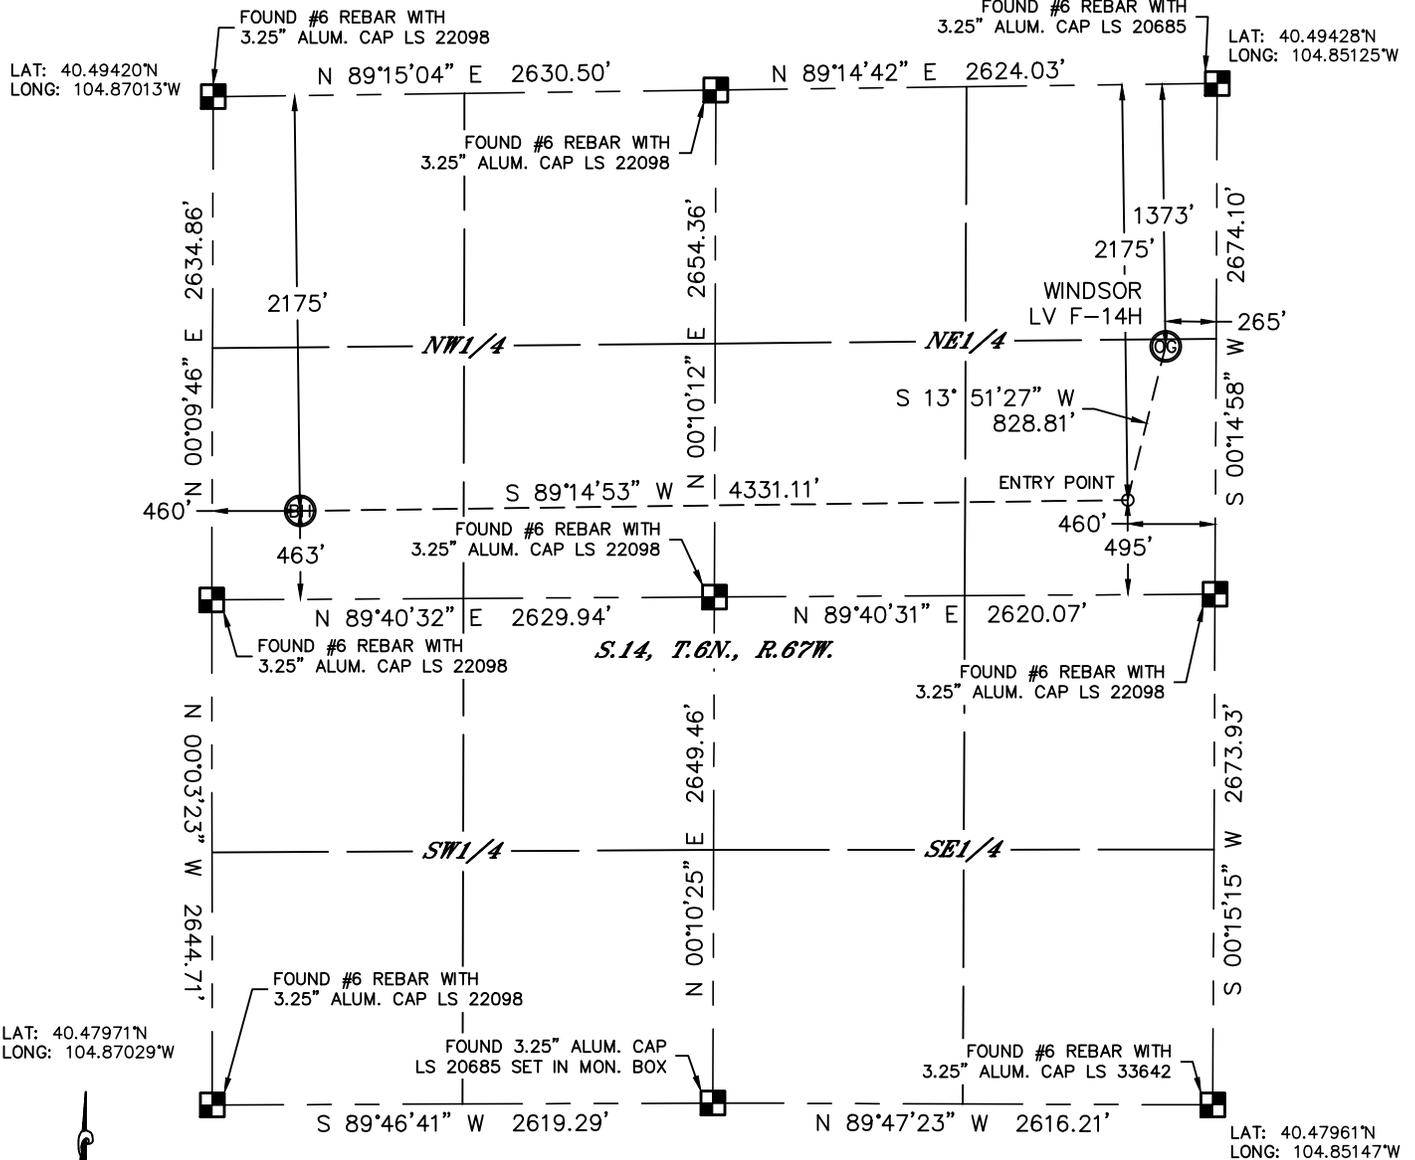

In accordance with a request from Jesse White with APOLLO OPERATING, LLC. Lat40°, Inc. has determined the surface location of the WINDSOR LV F-14H to be 1373' from the NORTH line and 265' from the EAST line and the bottom hole to be 2175' from the NORTH line and 460' from the WEST line as measured at right angles from the section lines of Section 14, Township 6 North, Range 67 West of the Sixth Principal Meridian, County of Weld, State of Colorado.

I hereby state that this Well Location Certificate was prepared by me, or under my direct supervision, that the fieldwork was completed on 4/25/2013, for and on behalf of APOLLO OPERATING, LLC. That this is not a Land Survey Plat or an Improvement Survey Plat, and that it is not to be relied upon for establishment of fence, building, or other future improvement lines.

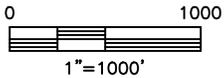

### NOTE:

- 1) Bearings shown are Grid Bearings of the Colorado State Plane Coordinate System, North Zone, North American Datum 1983/2007. The lineal dimensions as contained herein are based upon the "U.S. Survey Foot."
- 2) Ground elevations are based on an observed GPS elevation (NAVD 1988 DATUM).
- 3) IMPROVEMENTS: See LOCATION DRAWING for all visible improvements within 400' of disturbed area.
- 4) SURFACE USE: CROP LAND
- 5) INSTRUMENT OPERATOR: WYATT HALL

### SURFACE LOCATION

LAT: 40.49051°N  
LONG: 104.85226°W  
PDOP: 2.0  
ELEV: 4847'  
1/4: SE1/4NE1/4  
NEAREST PROPERTY LINE: 265' E

### ENTRY POINT

LAT: 40.48831°N  
LONG: 104.85299°W

### BOTTOM HOLE

LAT: 40.48824°N  
LONG: 104.86856°W

### NOTE

According to Colorado law, you must commence any legal action based upon any defect in this W.L.C. within three years after you discover such defect. In no event, may any action based upon any defect in this survey be commenced more than ten years after the date of the certificate shown hereon. (13-80-105 C.R.S.)

### LEGEND

- = ALIQUOT MONUMENT AS DESCRIBED
- = CALCULATED POSITION

Brian T. Brinkman—On behalf of Lat40°, Inc.  
Colorado Licensed Professional Surveyor  
Date: 4/26/2013  
Land Surveyor No. 38175 PROJECT#: 2012076






Lat40°, Inc. 1635 Foxtrail Drive, Suite 325 Loveland, CO 970-776-3321

# SITE SKETCH

WINDSOR LV F-14H

SECTION: 14  
TOWNSHIP: 6N  
RANGE: 67W

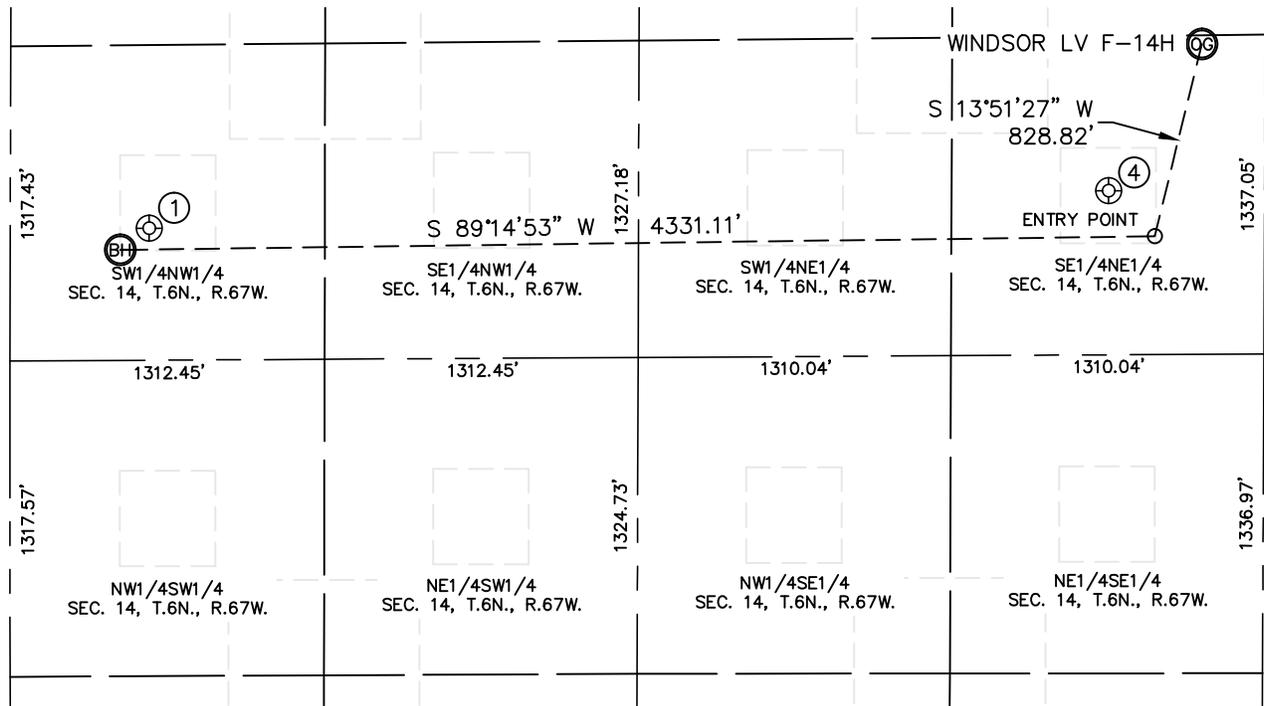


①

WINTER 1  
SW1/4NW1/4  
2086' FNL  
582' FWL  
LAT-40.48848°N  
LONG-104.86812°W  
PDOP: 3.9  
ELEV: 4802'

④

RUTZ #1 (COGCC)  
(Plugged & Abandoned)  
SE1/4NE1/4  
1982' FNL (COGCC)  
653' FEL (COGCC)  
LAT-40.48883°N (COGCC)  
LONG-104.85374°W (COGCC)  
PDOP: N/A  
ELEV: 4867' (COGCC)

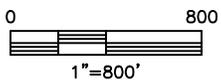

DATE: 4/26/2013  
PROJECT#: 2012076