


WELL LOCATION CERTIFICATE

SECTION: 18
TOWNSHIP: 4N
RANGE: 63W

THIS MAP DOES NOT REPRESENT A BOUNDARY SURVEY

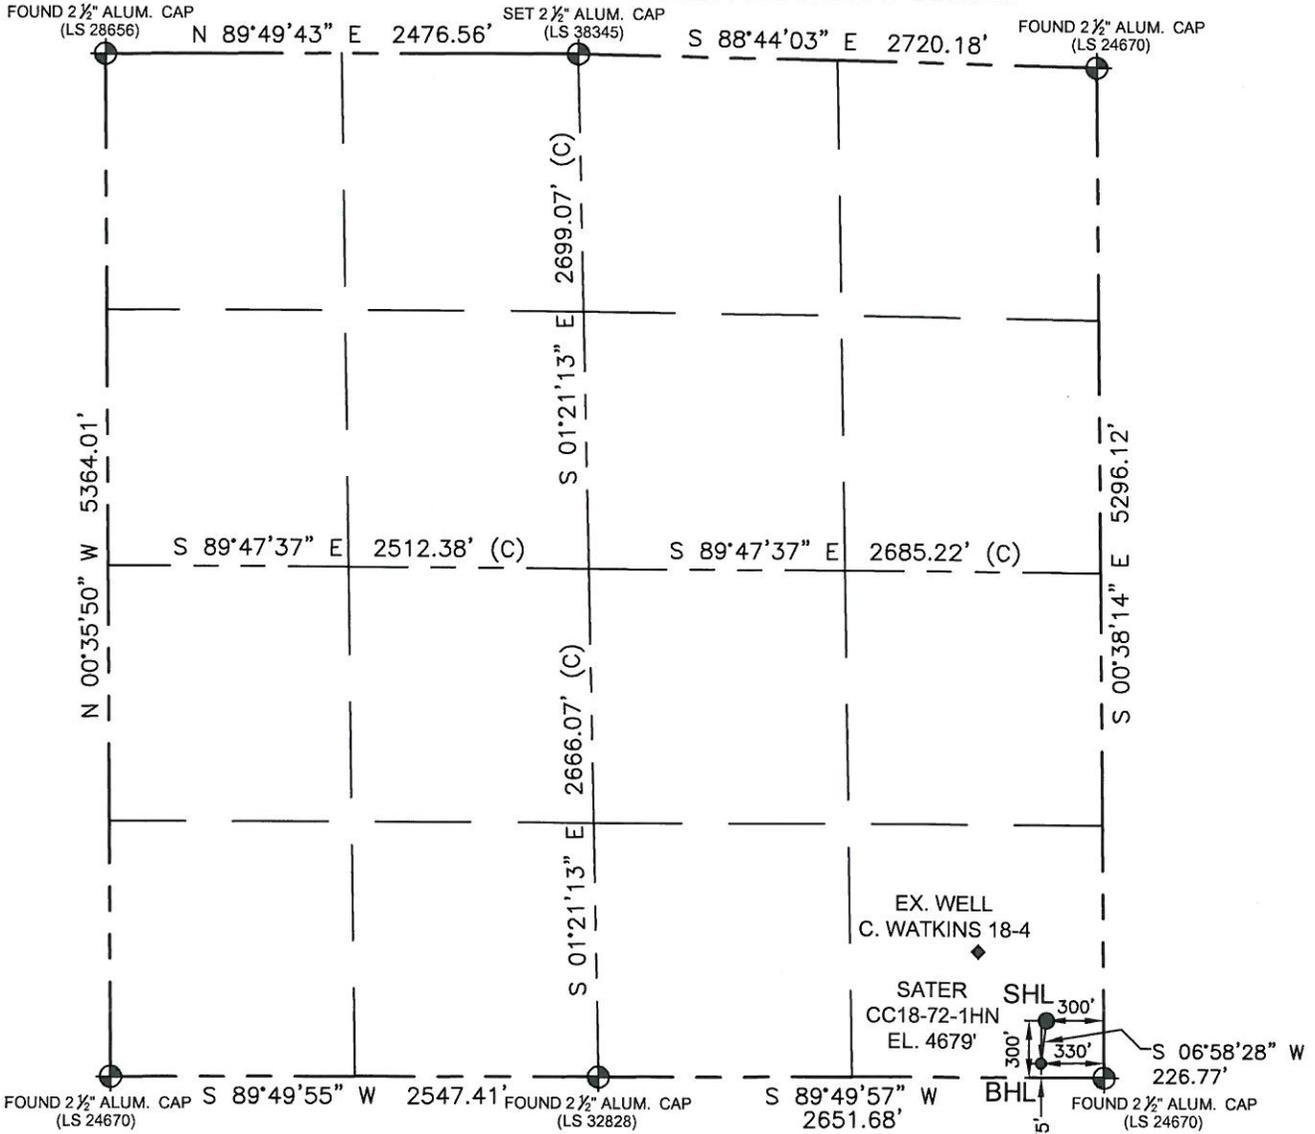


In accordance with a request from Matt Verbit with Noble Energy Inc. Petroleum Field Services, LLC has determined the surface location of the SATER CC18-72-1HN to be 300' from the SOUTH line and 300' from the EAST line and the bottom hole to be 75' from the SOUTH line and 330' from the EAST line as measured at right angles from the section line of Section 18, Township 4 North, Range 63 West of the Sixth Principal Meridian, County of WELD, State of Colorado.

I hereby state that this Well Location Certificate was prepared by me, or under my direct supervision, that the fieldwork was completed on 5/17/13, for and on behalf of Noble Energy Inc., that this is not a Land Survey Plat or an Improvement Survey Plat, and that it is not to be relied upon for establishment of fence, building, or other future improvement lines.

SURFACE LOCATION:
LATITUDE: 40.30562°N
LONGITUDE: 104.47212°W
PDOP: 1.78
ELEV: 4679'
¼¼: SE¼SE¼
NEAREST PROPERTY LINE: 300' South of East

BOTTOM HOLE:
LATITUDE: 40.30500°N
LONGITUDE: 104.47223°W

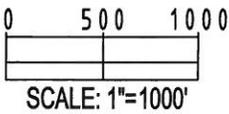


- Notes:
- 1) Bearings shown are Grid Bearings of the Colorado State Plane Coordinate System, North Zone, North American Datum 1983/2007. The lineal dimensions as shown herein are grid distances based upon the "U.S. Survey Foot."
 - 2) Ground elevations are based on an observed GPS elevation (NAVD 1988 DATUM).
 - 3) NEAREST EXISTING WELL IN SECTION 18 IS: C. WATKINS 18-4, 506' NW
 - 4) IMPROVEMENTS: See LOCATION DRAWING exhibit for all visible improvements within 400' of disturbed area.
 - 5) SURFACE USE: RANGELAND
 - 6) INSTRUMENT OPERATOR: DAVID MACDONALD

Note:
According to Colorado law, you must commence any legal action based upon any defect in this W.L.C. within three years after you first discover such defect. In no event, may any action based upon any defect in this survey be commenced more than ten years after the date of this certification shown hereon. (13-80-105 C.R.S.)

LEGEND

- ⊕ = FOUND MONUMENT
- = PROPOSED WELL
- ◆ = BOTTOM HOLE
- ◆ = EXISTING WELL

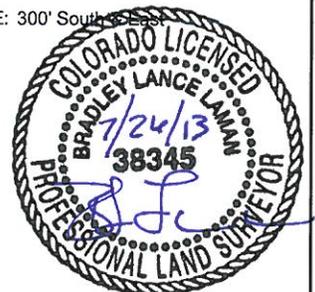


BRADLEY L. LAMAN, PLS 38345
COLORADO LICENSED PROFESSIONAL LAND SURVEYOR
FOR AND ON BEHALF OF P.F.S., LLC


DRAWING DATE: 07-2613
DRAWN BY: KAD
CHECKED BY: TJN

SITE SKETCH

SECTION: 18
TOWNSHIP: 4N
RANGE: 63W

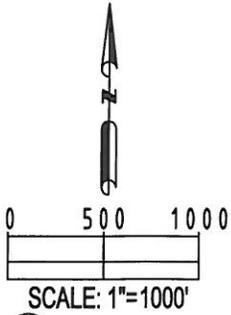

- ① C WATKINS 18-4
SE $\frac{1}{4}$ SE $\frac{1}{4}$
659' FSL / 653' FEL
LAT-40.30661°N
LONG-104.47338°W
PDOP: 1.78
ELEV: 4667'
- ② SATER CC 18-23
NE $\frac{1}{4}$ SE $\frac{1}{4}$
1339' FSL / 1233' FEL
LAT-40.30849°N
LONG-104.47546°W
PDOP: 1.78
ELEV: 4653'
- ③ WATKINS 18-9
NE $\frac{1}{4}$ SE $\frac{1}{4}$
1949' FSL / 835' FEL
LAT-40.31016°N
LONG-104.47403°W
PDOP: 1.78
ELEV: 4651'
- ④ C WATKINS 18-6
SE $\frac{1}{4}$ NE $\frac{1}{4}$
2017' FNL / 628' FEL
LAT-40.31385°N
LONG-104.47329°W
PDOP: 1.78
ELEV: 4650'
- ⑤ WATKINS CC 18-01J
NE $\frac{1}{4}$ NE $\frac{1}{4}$
951' FNL / 1075' FEL
LAT-40.31681°N
LONG-104.47489°W
PDOP: 1.78
ELEV: 4640'
- ⑥ SATER CC 18-01
NE $\frac{1}{4}$ NE $\frac{1}{4}$
498' FNL / 499' FEL
LAT-40.31801°N
LONG-104.47282°W
PDOP: 1.78
ELEV: 4659'
- ⑦ WOLFE USX CC 7-23
SE $\frac{1}{4}$ SE $\frac{1}{4}$
1155' FSL / 1320' FEL
LAT-40.32262°N
LONG-104.47578°W
PDOP: 1.78
ELEV: 4627'
- ⑧ WOLFE USX CC 7-16
SW $\frac{1}{4}$ SE $\frac{1}{4}$
565' FSL / 667' FEL
LAT-40.32094°N
LONG-104.47343°W
PDOP: 1.78
ELEV: 4641'
- ⑨ GUTTERSON-USX CC 17-13
SW $\frac{1}{4}$ SW $\frac{1}{4}$
759' FSL / 645' FWL
LAT-40.30690°N
LONG-104.46873°W
PDOP: 1.78
ELEV: 4705'
- ⑩ GUTTERSON USX CC 17-25
SE $\frac{1}{4}$ SW $\frac{1}{4}$
1316' FSL / 1292' FWL
LAT-40.30845°N
LONG-104.46641°W
PDOP: 1.78
ELEV: 4705'
- ⑪ GUTTERSON USX CC 17-12
NW $\frac{1}{4}$ SW $\frac{1}{4}$
2082' FSL / 1292' FWL
LAT-40.31053°N
LONG-104.46872°W
PDOP: 1.78
ELEV: 4680'
- ⑫ GUTTERSON USX CC 17-5
SW $\frac{1}{4}$ NW $\frac{1}{4}$
1980' FNL / 661' FWL
LAT-40.31389°N
LONG-104.46867°W
PDOP: 1.78
ELEV: 4676'
- ⑬ GUTTERSON USX CC 17-04
NW $\frac{1}{4}$ NW $\frac{1}{4}$
673' FNL / 655' FWL
LAT-40.31748°N
LONG-104.46869°W
PDOP: 1.78
ELEV: 4680'

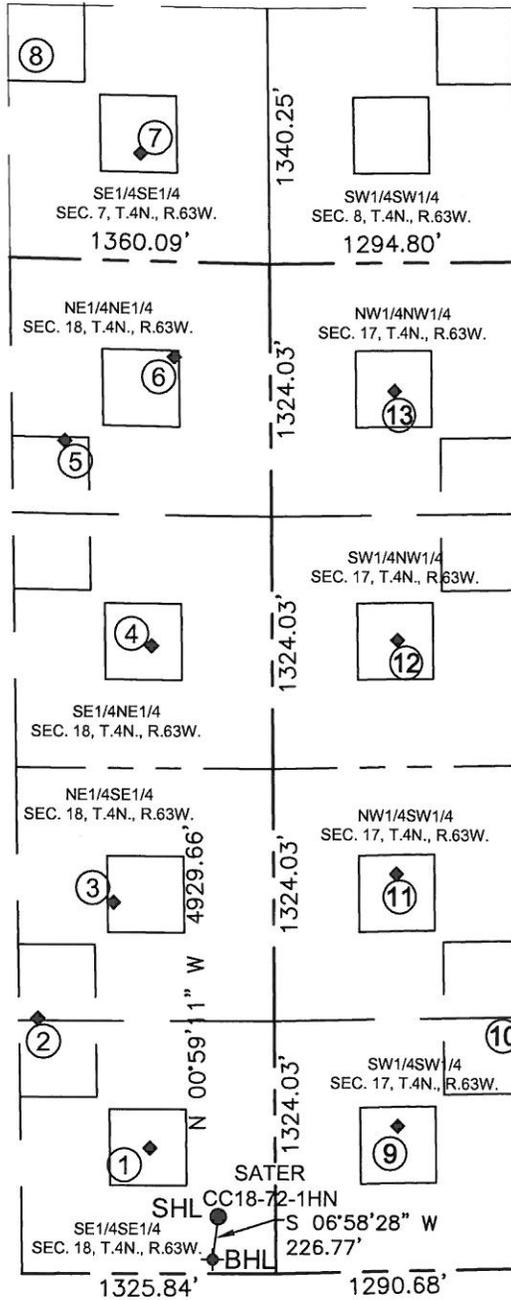

| |
|---------------------------|
| FIELD DATE: 05-17-13 |
| DRAWING DATE: 07-26-13 |
| DRAWN BY: KAD |
| CHECKED BY: TJN |

LEGEND

- = FOUND MONUMENT
- = PROPOSED WELL
- = BOTTOM HOLE
- = EXISTING WELL