


WELL NAME: WHISKEY JACK 16-9-63  
AS PLUGGED 5-3-12

SESE SEC 16 T9N R63W  
605 FSL & 605 FEL  
WELD CO, CO.  
API# 05-123-32012

GL 5202'  
KB 5202'

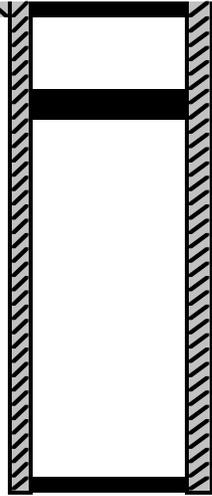

CUT OFF 4' BELOW GL  
PLUG 2 50-4' W/ 20 SXS CLASS G NEAT @ 15.8 PPG

PLUG #1 @ 265-154' W/ 45 SXS CLASS G NEAT @ 15.8 PPG. WO CEMENT AND TAG @154'

PBTD @ -1170'  
SURFACE 9 5/8" 36# K55 1211'

HOLE SIZE	PIPE SIZE	WEIGHT	GRADE	SACKS	SET DEPTH
12 1/4"	9 5/8"	36#	K55	450	1211'

P&A 5-3-12

NOTE: NOT TO SCALE

NOTE: SHOE JOINT NEVER DRILLED