WELLBORE DIAGRAM

Bonanza Creek Energy
State Antelope O-K-24 HNB

SHL: 165' FSL & 1524' FEL SWSE
Sec 24 T5N R62W
BHL: 502' FNL & 2672' FEL
Sec 24 T5N R62W
Weld County, CO
05-123-36467

Spud Date: 2/12/2013

KB Elev	4533'	ft
GL Elev	4517'	ft
KB to GL	16'	ft
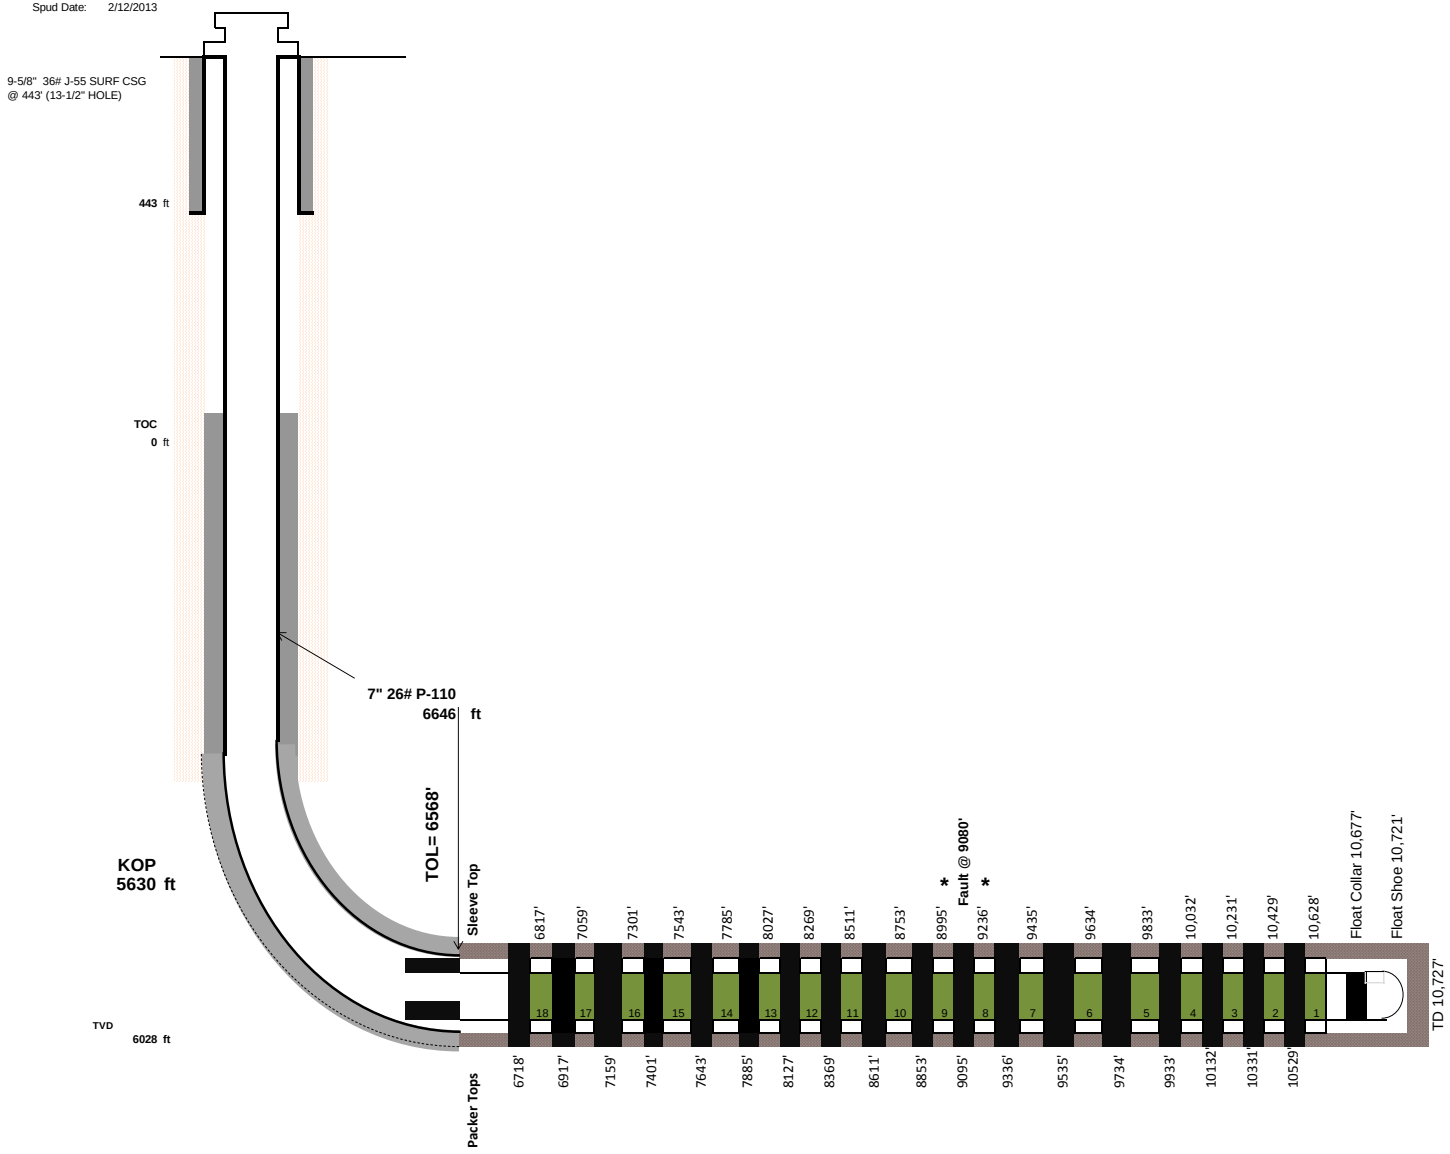
Updated Date
3/11/2013