

WELLBORE DIAGRAM

Bonanza Creek Energy
State Antelope 44-41-24 HNB

SHL: 185' FSL & 1524' FEL SWSE
 Sec 24 T5N R62W
 BHL: 465' FNL & 641' FEL
 Sec 24 T5N R62W
 Weld County, CO
 05-123-36468

KB Elev 4533' ft
 GL Elev 4516' ft
 KB to GL 17' ft

Updated Date
 8/2/2013

Spud Date: 2/18/2013

9-5/8" 36# J-55 SURF
 CSG @ 439' (13-1/2"
 HOLE)

439' ft

TOC
 0 ft

7" 26# P-110
 6548 ft


KOP
 5635 ft

TOL= 6475'

Sleeve Top

TVD
 6013 ft

Packer Tops

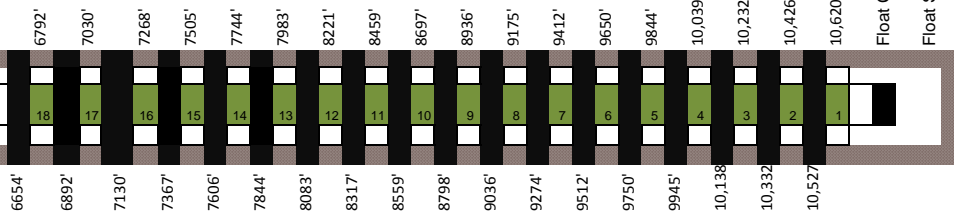

TD 10,742'