Propst #1 SWSW Sec 26-11N-53W Logan Co., CO

Water Disposal
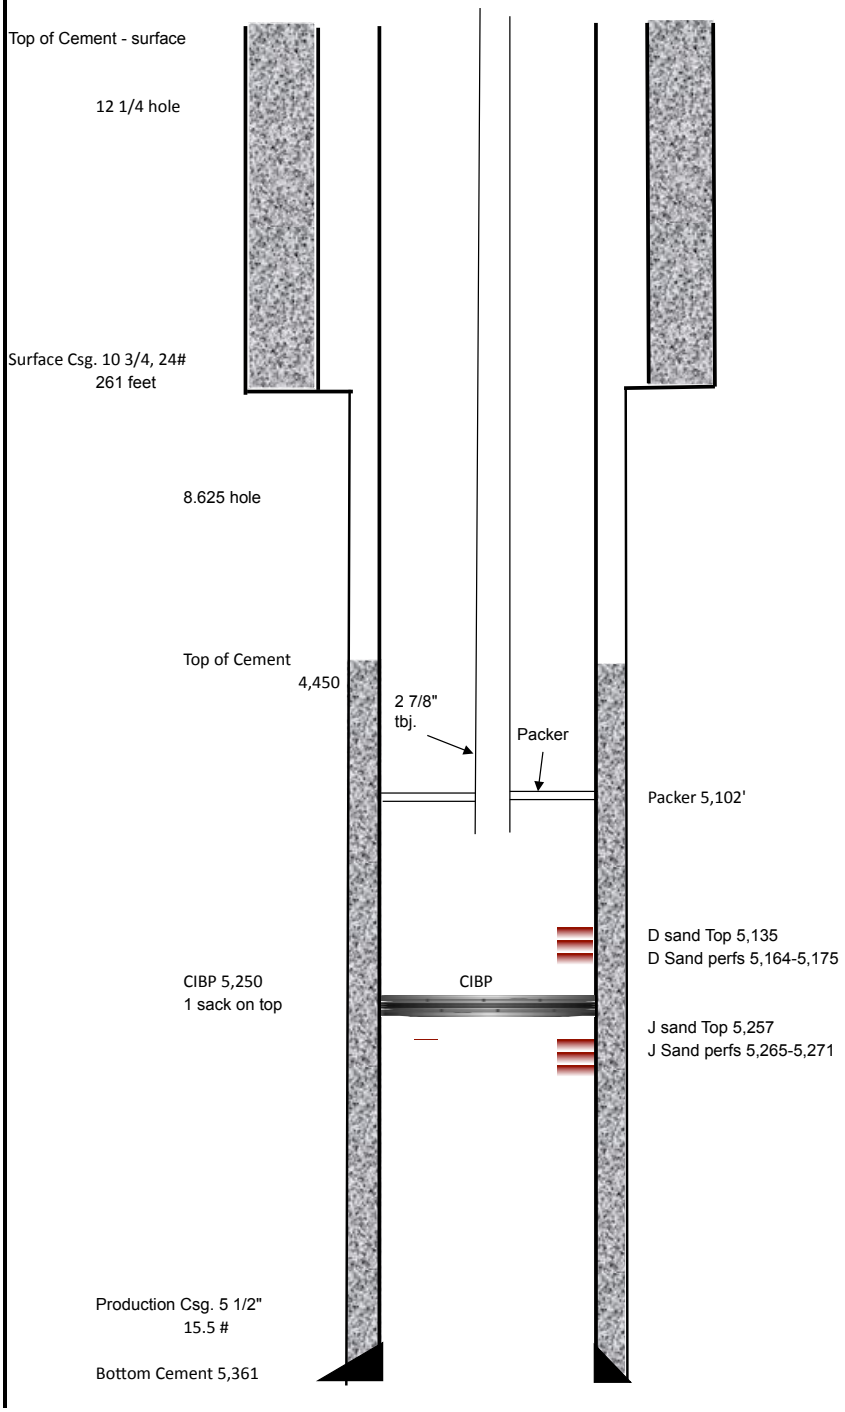
API # 0507509204