



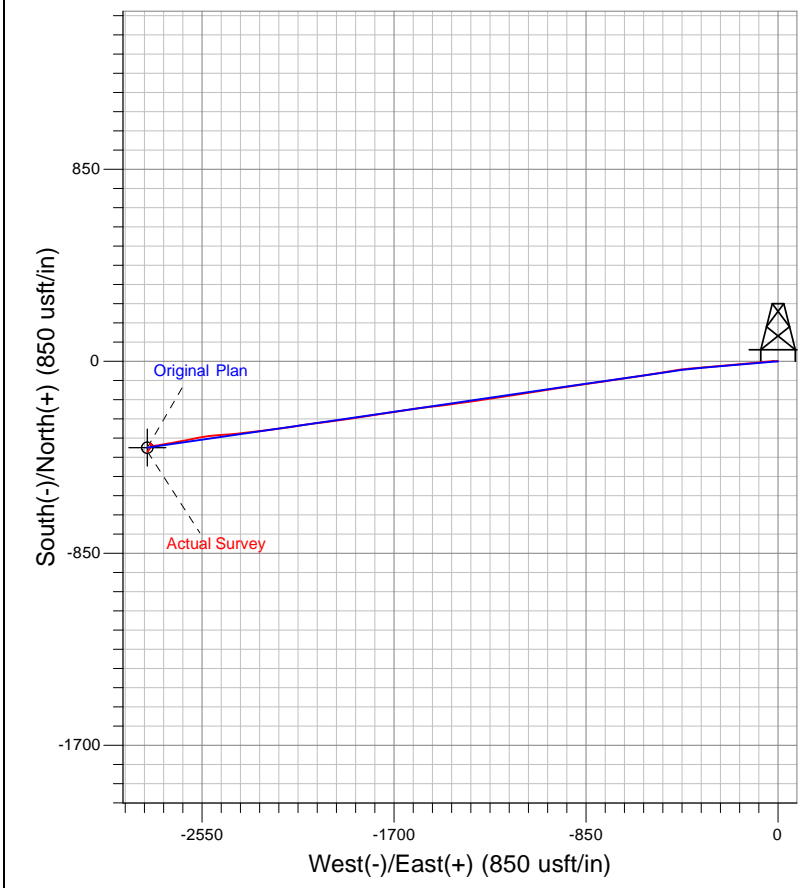

Well Name: PA 333-2  
Surface Location: GV 84-1 Pad - West Cellar  
North American Datum 1983 , US State Plane 1983 . Colorado Central Zone  
Ground Elevation: 6027.00  
+N/-S +E/-W Northing Easting Latitude Longitude Slot  
0.00 0.00 1604005.10 2307268.50 39.46608 -107.95400 B10  
KELLY BUSHING @ 6053.00usft (SSD 574 (26' RKB) jjb)

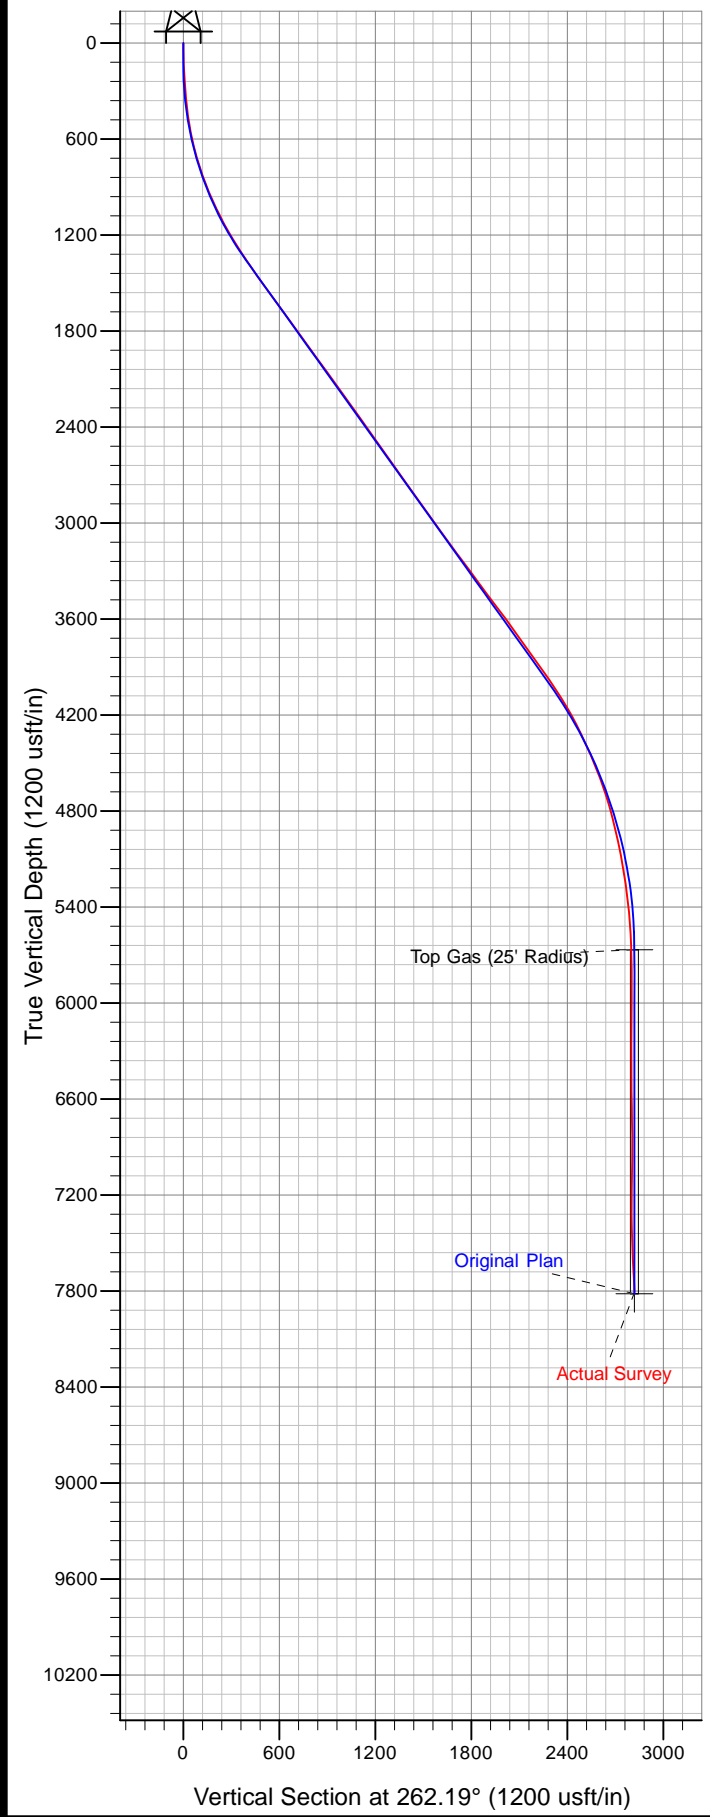

T  
M

Azimuths to True North  
Magnetic North: 10.10°

Magnetic Field  
Strength: 52058.0snT  
Dip Angle: 65.67°  
Date: 3/31/2013  
Model: IGRF2010