


WELL NAME: State #14-36
OPERATOR: Aexco Inc
COMP ZONE: J Sand
LOCATION: 9N 59W S36 SE SW

COUNTY: Weld
STATE: Colorado
API : 05-123-13895

SPUD: 3/24/88
P&A: 3/30/88
GL: 4,838'

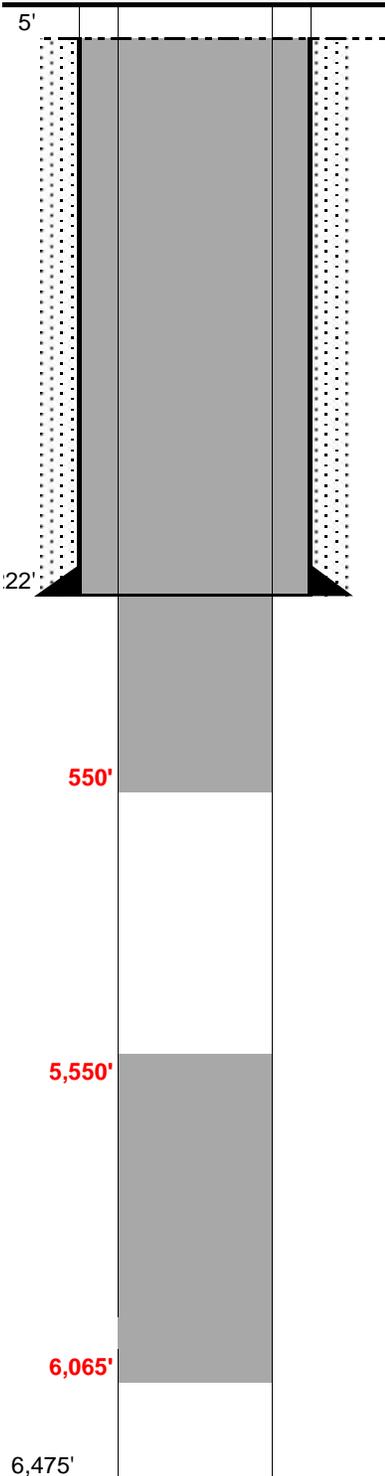

SURFACE CASING

DEPTH: 222' SIZE: 8.625" GRADE: _____ WT (#/ft): 24.0
 CEMENT: 130 sx
 COMMENTS: _____

PRODUCTION CASING

DEPTH: _____ SIZE: _____ GRADE: _____ WT (#/ft): _____
 CEMENT: _____ TOC: _____
 COMMENTS: _____

PERFS: _____ PROD ZONE 1: J Sand Drill Stem test
 PERFS: _____ - _____ ZONE 2: D Sand drill stem test
 PERFS: _____ - _____ ZONE 3: _____

PREVIOUS PLUGS

RECOVERED: _____ SIZE: _____
 CMT 1: 200' - 240' COMMENT: 20 sx
 CMT 2: 0' - 30' COMMENT: 10 sx - surface
 CMT 3: _____ - _____ COMMENT: _____
 OTHER: Proposed Plug 1: 5,550' - 6,065' (Across Niobrara and 200' above)
Proposed Plug 2: 5' - 550' (Surface and Potential FW zone)

FORMATIONS:

NIOBRARA: 5,827'
 FORT HAYS 6,064'
 CODELL 6,114'
 BENTONITE 6,467'
 D SAND 6,570'
 J SAND 6,640'