

Colorado Division of Water Resources

Colorado's Well Permit Search

Well Constructed

Last Refresh: 7/2/2013 12:01:17 AM

Receipt:	9014313	Division:	1
Permit #:	16942- -	Water District:	49
Well Name / #:		County:	CHEYENNE
Designated Basin:	NORTHERN HIGH PLAINS	Management District:	EASTERN CHEYENNE

Case Number:

WDID:

☐ Applicant/Owners History

Date Range	Applicant/Owner Name	Address	City/State/Zip
Unknown - Present	MITCHEK CHARLEY		CHEYENNE WLS, CO 80810

☐ Location Information

Approved Well Location:

Q40 Q160 Section Township Range PM Footage from Section Lines

NE NE 11 14.0S 45.0W Sixth

Northing (UTM y): 4303783.9 **Easting (UTM x):** 724781.5

Location Accuracy: Spotted from quarters

Physical Address

City/State/Zip

Subdivision Name

Filing Block Lot

Parcel ID:

Acres in Tract:

☐ Permit Details

Date Issued: Date Expires:

Use(s):	STOCK
Special Use:	

Aquifer(s): ALL UNNAMED AQUIFERS

Area which may be irrigated:

Maximum annual volume of appropriation:

Statute:

Permit Requirements: Totalizing Flow Meter Geophysical Log Abandonment Report

No

No

No

Cross Reference

Permit(s):

Permit Number Receipt Description

Comments:

☐ Construction/Usage Details

Well Construction Date: Pump Installation Date:

Well Plugged: 1st Beneficial Use: 08/20/1963

Elevation Depth	Perforated Casing (Top)	Perforated Casing (Bottom)	Static Water Level	Pump Rate
228			198	5

☐ Application/Permit History

First Beneficial Use 08/20/1963

☐ Imaged Documents

Document Name Date Imaged Annotated

[Original File](#) 12/07/2007 No

[Original File](#) 12/07/2007 No

Copyright © 2009 Colorado Division of Water Resources. All rights reserved.

[Home](#) | [Contact Us](#) | [Help](#) | [Water Links](#) | [Colorado.gov](#) | [DNR](#) | [Privacy Policy](#) | [Transparency Online Project \(TOP\)](#)

Colorado Department of Natural Resources

[Colorado.gov](#) | [Contact Us](#)



Colorado's Well Permit Search

Well Constructed

Last Refresh: 7/2/2013 12:01:17 AM

Receipt:	9014313	Division:	1
Permit #:	16942- -	Water District:	49
Well Name / #:		County:	CHEYENNE
Designated	NORTHERN HIGH	Management	EASTERN

Basin: PLAINS

District: CHEYENNE

Case Number:

WDID:

☐ Applicant/Owners History

Date Range	Applicant/Owner Name	Address	City/State/Zip
Unknown - Present	MITCHEK CHARLEY		CHEYENNE WLS, CO 80810

☐ Location Information

Approved Well Location:

Q40 Q160 Section Township Range PM Footage from Section Lines

NE NE 11 14.0S 45.0W Sixth

Northing (UTM y): 4303783.9 **Easting (UTM x):** 724781.5

Location Accuracy: Spotted from quarters

Physical Address

City/State/Zip

Subdivision Name

Filing Block Lot

Parcel ID:

Acres in Tract:

☐ Permit Details

Date Issued: Date Expires:

Use(s):

STOCK

Special Use:

Aquifer(s): ALL UNNAMED AQUIFERS

Area which may be irrigated:

Maximum annual volume of appropriation:

Statute:

Permit Requirements: Totalizing Flow Meter Geophysical Log Abandonment Report

No

No

No

Cross Reference

Permit(s):

Permit Number Receipt Description

Comments:

[-] Construction/Usage Details

Well Construction Date: Pump Installation Date:

Well Plugged: 1st Beneficial Use: 08/20/1963

Elevation	Depth	Perforated Casing (Top)	Perforated Casing (Bottom)	Static Water Level	Pump Rate
	228			198	5

[-] Application/Permit History

First Beneficial Use 08/20/1963

[-] Imaged Documents

Document Name	Date Imaged	Annotated
----------------------	--------------------	------------------

Original File	12/07/2007	No
-------------------------------	------------	----

Original File	12/07/2007	No
-------------------------------	------------	----

Copyright © 2009 Colorado Division of Water Resources. All rights reserved.

OCT 1 1963

Form 5 (Rev.)

3-62

OCT 3 0 1963

STATE OF COLORADO
DIVISION OF WATER RESOURCES
OFFICE OF THE STATE ENGINEER
GROUND WATER SECTION

LOG AND HISTORY OF WELL

PERMIT NO. 16942

RECEIVED

OCT 3 1963
GROUND WATER SECT.
COLORADO
STATE ENGINEER

Index No. 478
IDWD 2-49
Use Stock
Registered 10-8-63

Driller Russell R. Rye Lic. No. 420Owner Charley MitchellStreet _____ City Cheyenne Wells

Tenant _____

Use of Water LivestockOn or By Sec 11 Twp 14 Rge 45 No. _____ Acres _____
(description of site of land)Date Started Aug 15, 19 63Date Completed Aug 20, 19 63Yield 5 GPM or _____ CFS

WELL DESCRIPTION:

Depth to Water 195 ft. Total Depth 228 ft.
(measured from ground surface)

Hole Diameter { from 0 ft. to 228 ft., 8 in.
from _____ ft. to _____ ft., _____ in.
from _____ ft. to _____ ft., _____ in.

TEST DATA:

How Tested ✓ Pump or _____ BailedDate Tested Aug 20, 19 63 Length 10 hrs.Rate 5 GPM Drawn Down None ft.

PUMP DATA:

Pump Type Plunger Outlet Size 1 1/2 in.Driven by Windmill HP _____

CASING RECORD:

Plain Casing

Size 5 in, Kind Galv from 0 ft. to 210 ft.

Size _____, Kind _____ from _____ ft. to _____ ft.

Size _____, Kind _____ from _____ ft. to _____ ft.

Perforated Casing


Size 5 in, Kind Galv from 210 ft. to 228 ft.

Size _____, Kind _____ from _____ ft. to _____ ft.

Size _____, Kind _____ from _____ ft. to _____ ft.

WELL LOCATION

Cheyenne County 09
NE 1/4 of NE 1/4 of Sect. 11
Twp. 14 S, Rge. 45 W, L 6 PM

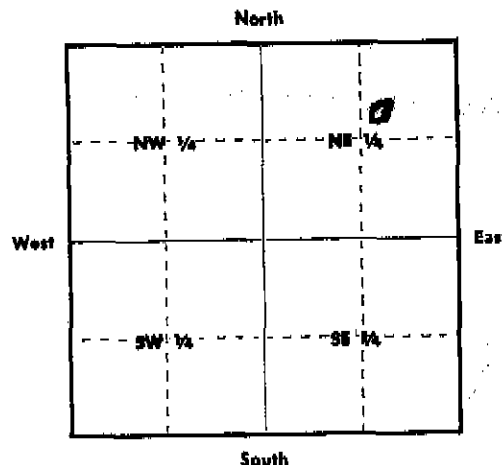

ABOVE DIAGRAM REPRESENTS ONE FULL SECTION. LOCATE WELL ACCURATELY IN SMALL SQUARE REPRESENTING 40 ACRES.

or

If the above is not applicable fill in:

No. _____ Street _____

City or Town _____

or

Lot _____, Block _____

_____ Subdivision
(include filing or number)

TO BE MADE OUT IN QUADRUPLICATE:

Original Blue and Duplicate Green Copy must be filed with the State Engineer within 30 days after well is completed. White copy is for the Owner and Yellow copy for the Driller.

FOR WELL LOG USE REVERSE SIDE