

**VORTEX 12-53-3-1**  
WELLBORE SCHEMATIC AS PLUGGED

**Surface Loc:** NENE Sec 3, T12S, R53W

**BH Loc:** NENE Sec 3, T12S, R53W


**County:** LINCOLN **State:** COLORADO

39.03649° & -103.31517° (Nad 83) As Built

7377' MD

7377' TVD

**API#** 05-073-06535

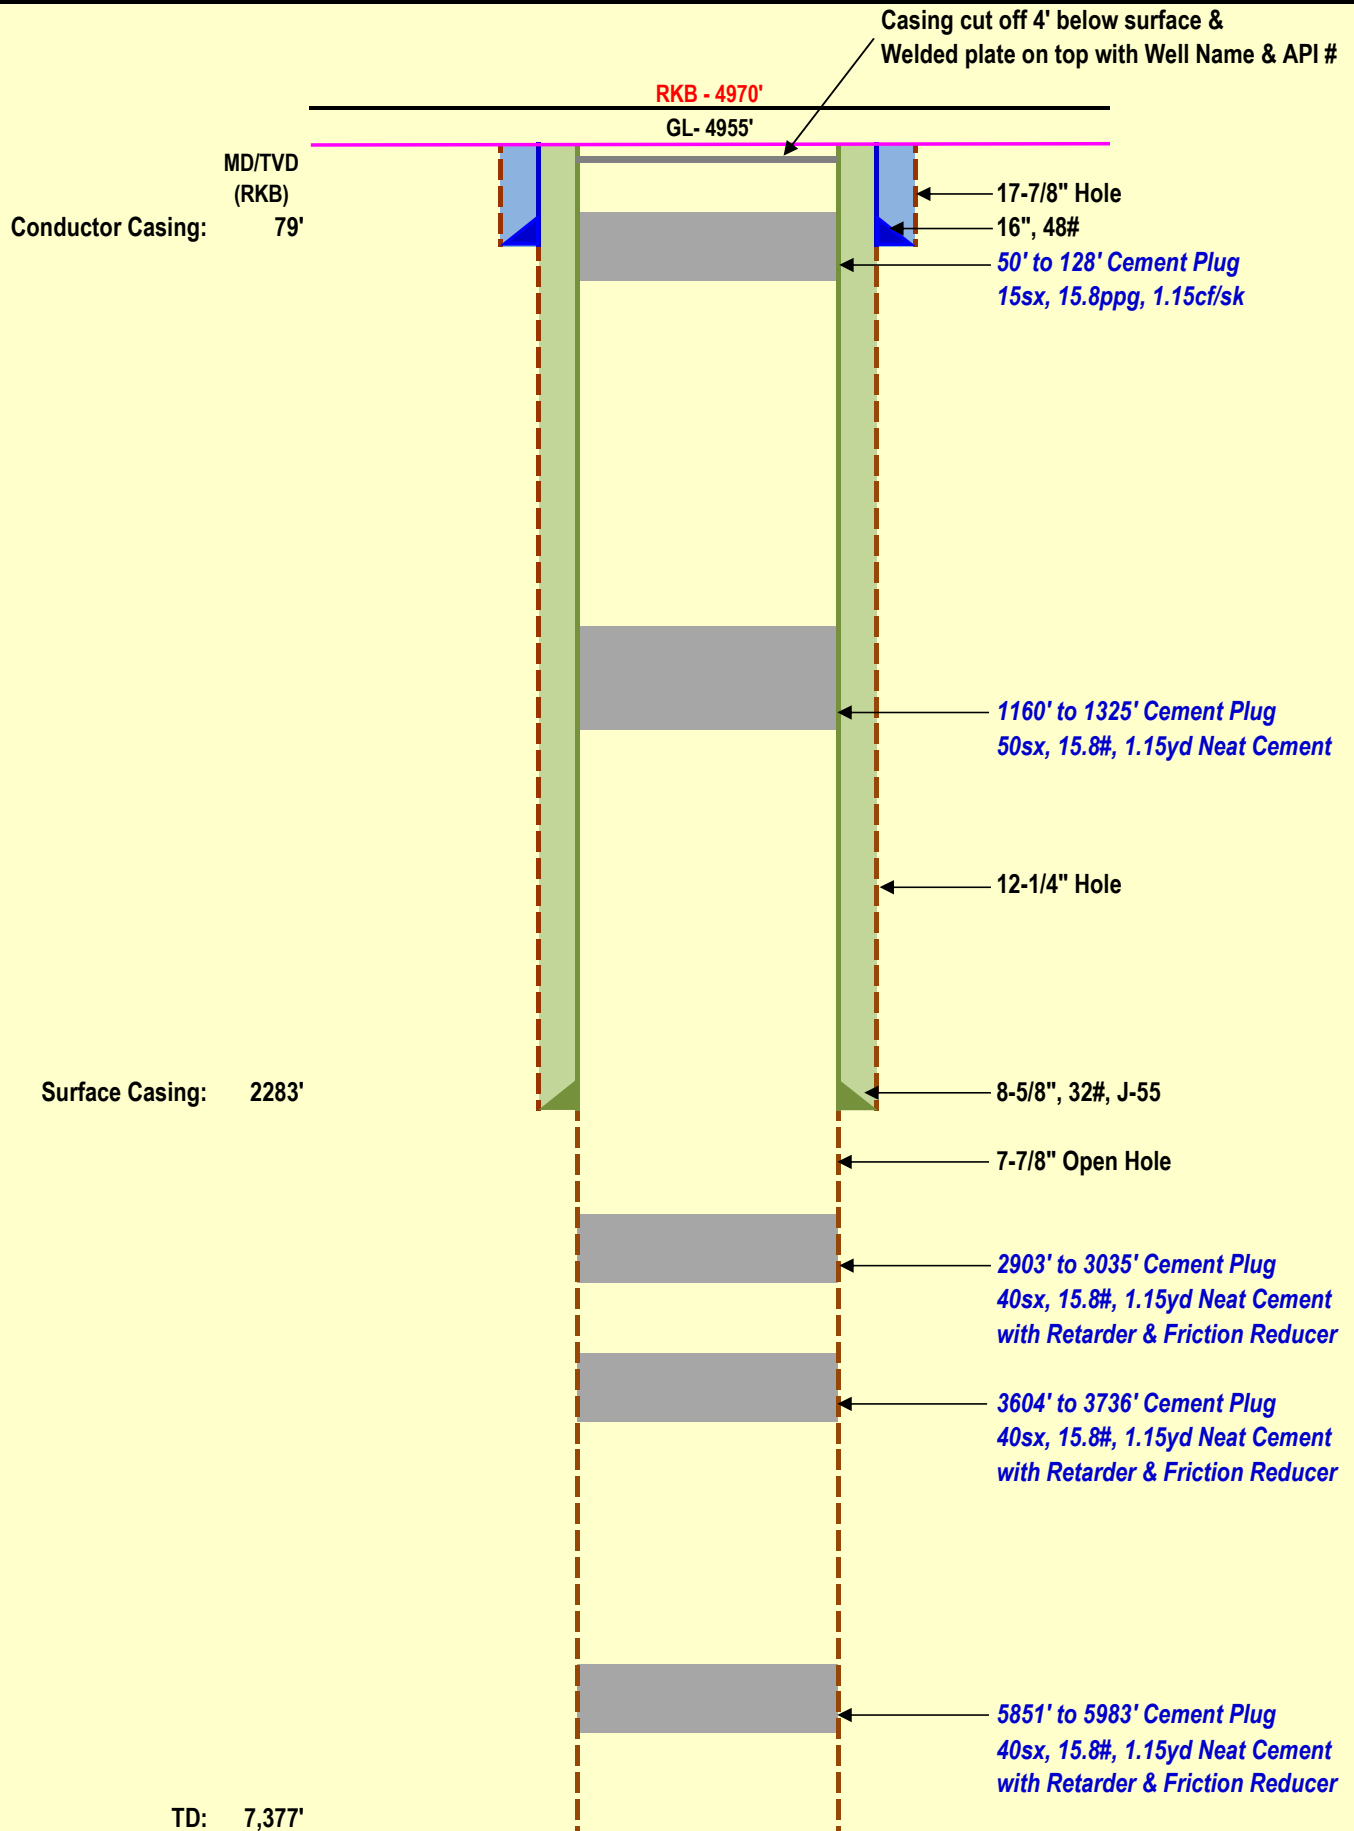

NOT TO SCALE