




Lease Name: Willson #1-15

Legals: NENE – Sec. 15, T6N, R65W

County: Weld County, Colorado

API#: 05-123-13327

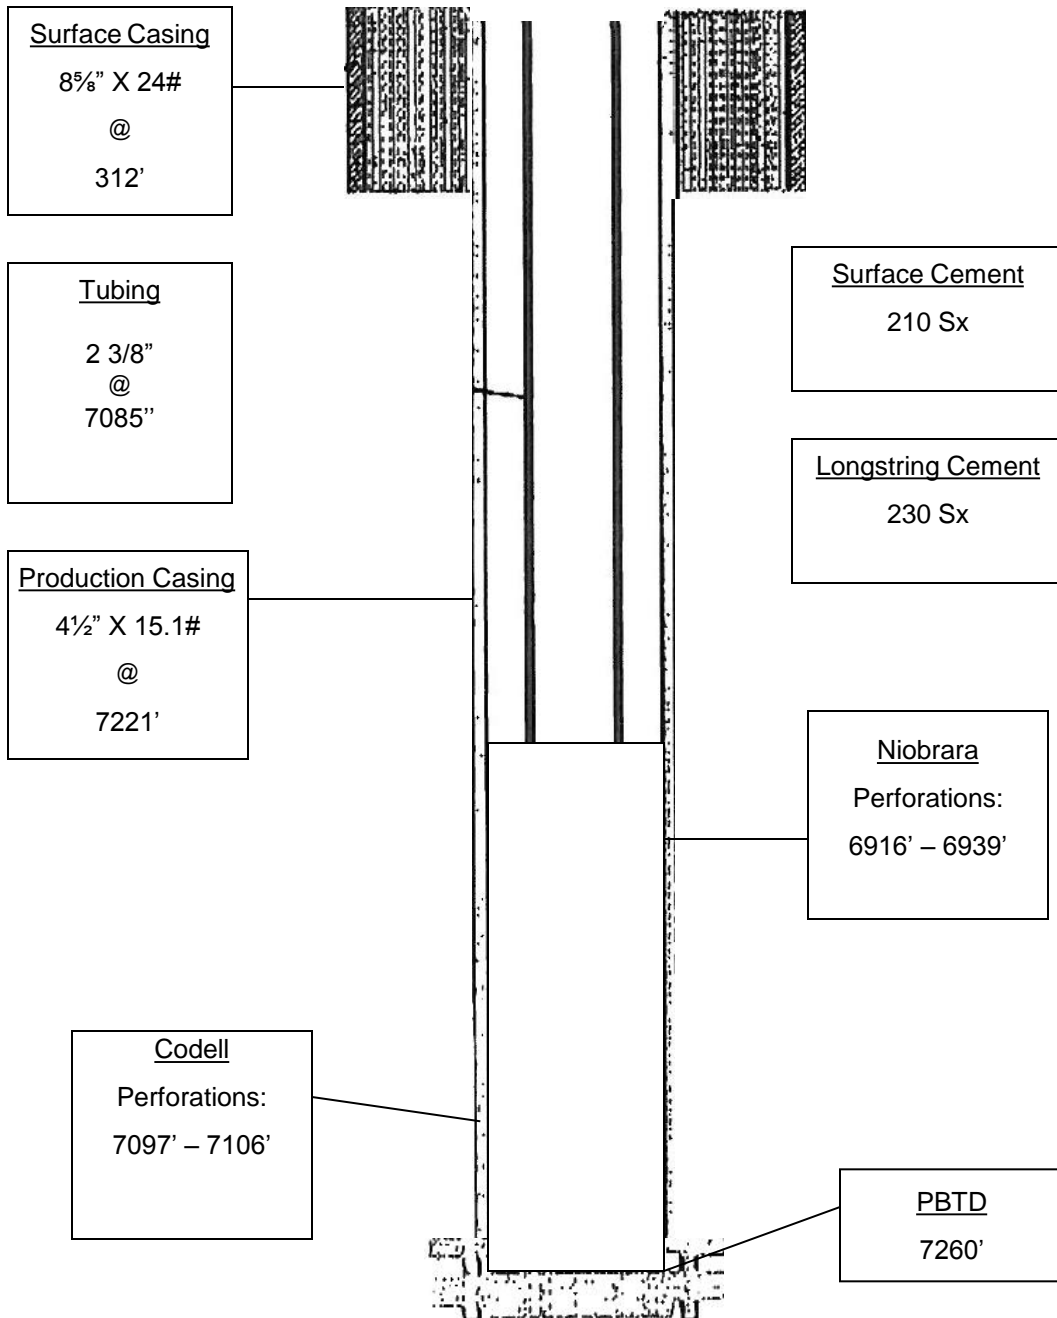

Wellbore Diagram