


FIGURES

Location Maps

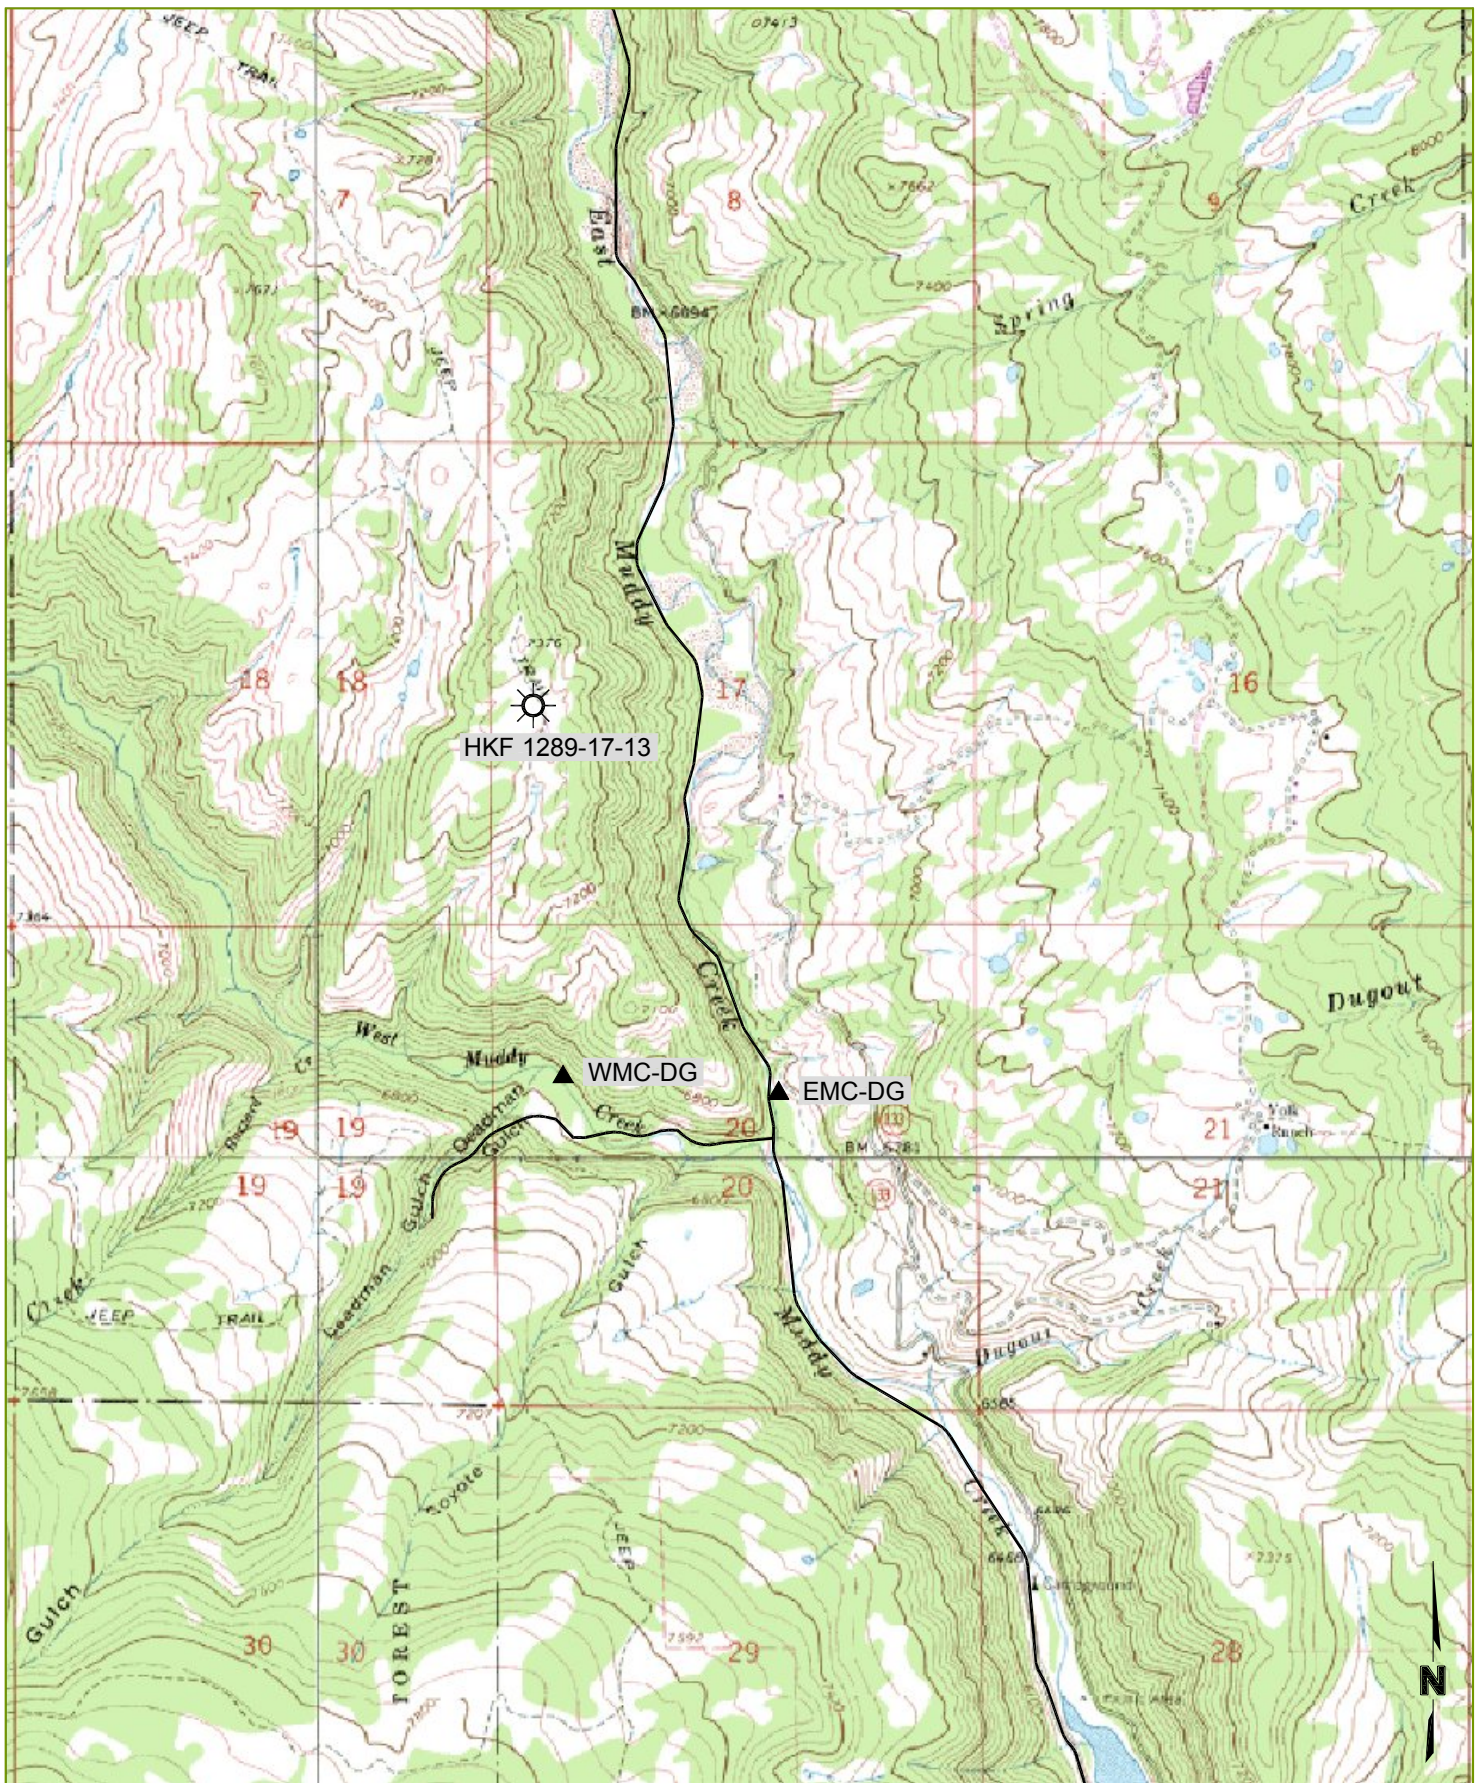

MAP SOURCE: 7.5 MINUTE U.S.G.S. TOPOGRAPHIC MAP (CHAIR MT QUADRANGLE)

PROJECT NO: 010-1370

DRAWN BY: DMP

DATE: 7/13/10


SITE LOCATION MAP
GUNNISON ENERGY CORPORATION
HOTCHKISS FEDERAL 1289-17-13
GUNNISON COUNTY, COLORADO

OLSSON
ASSOCIATES

826 21½ Road
Grand Junction, CO 81505
TEL 970.263.7800
FAX 970.263.7456

FIGURE

1

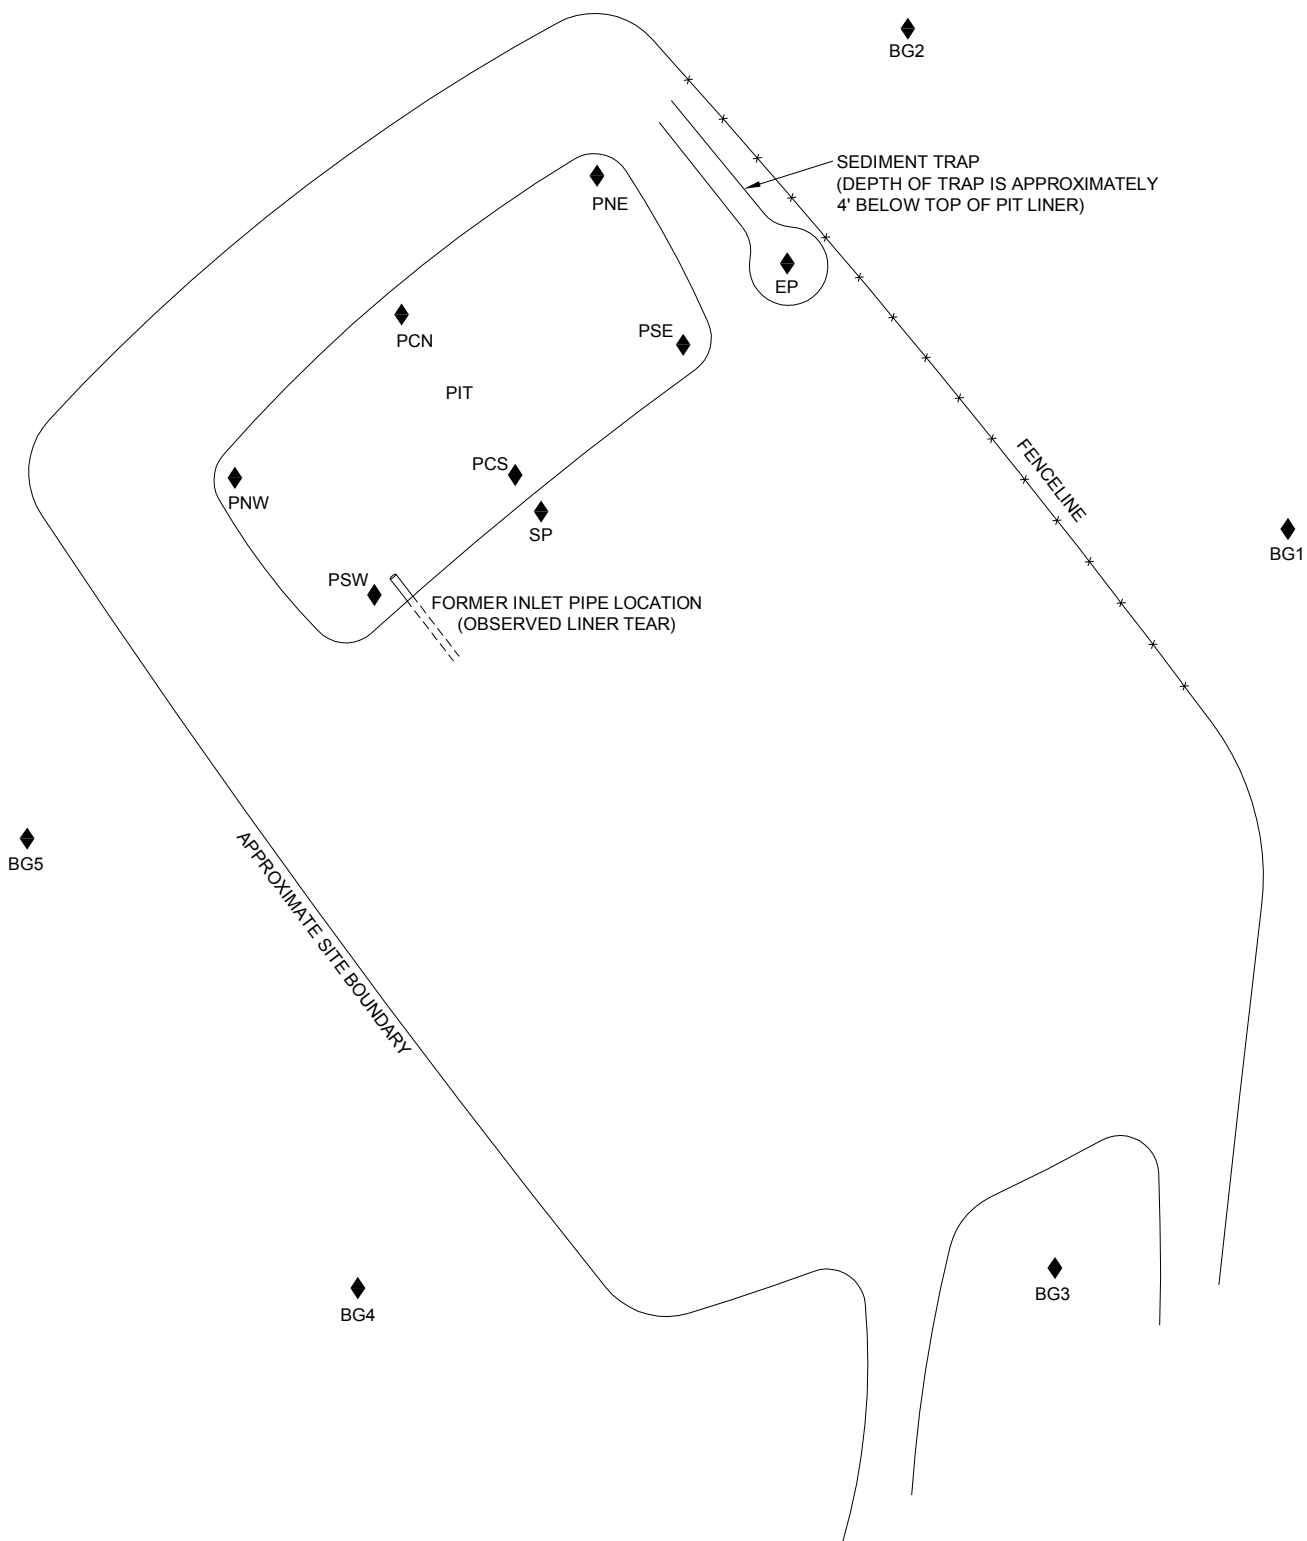

LEGEND

◆ = SOIL SAMPLE LOCATION

PROJECT NO: 010-1370

DRAWN BY: DMP

DATE: 8/11/10

SAMPLE LOCATION/SITE MAP
GUNNISON ENERGY CORPORATION
HOTCHKISS FEDERAL 1289-17-13
GUNNISON COUNTY, COLORADO

OLSSON
ASSOCIATES

826 21½ Road
Grand Junction, CO 81505
TEL 970.263.7800
FAX 970.263.7456

FIGURE

2