




**Job Number:** Wind 17-14 Pad  
**Company:** Trilogy Resources, LLC  
**Lease/Well:** Wind 17-14  
**Location:** SEC 17 T4N R67W  
**Rig Name:** Cade 25  
**State/County:** CO/ Weld  
**Country:** USA  
**API Number:** 05-123-36436

**Elevation (To MSL):** 4839.00 ft  
**RKB:** 13.00 ft  
**Projection System:** US State Plane 1983  
**Projection Group:** Colorado Northern Zone  
**Projection Datum:** GRS80  
**Magnetic Declination:** 8.63  
**Grid Convergence:** 0.37685 E  
**Date:** Sunday, July 21, 2013

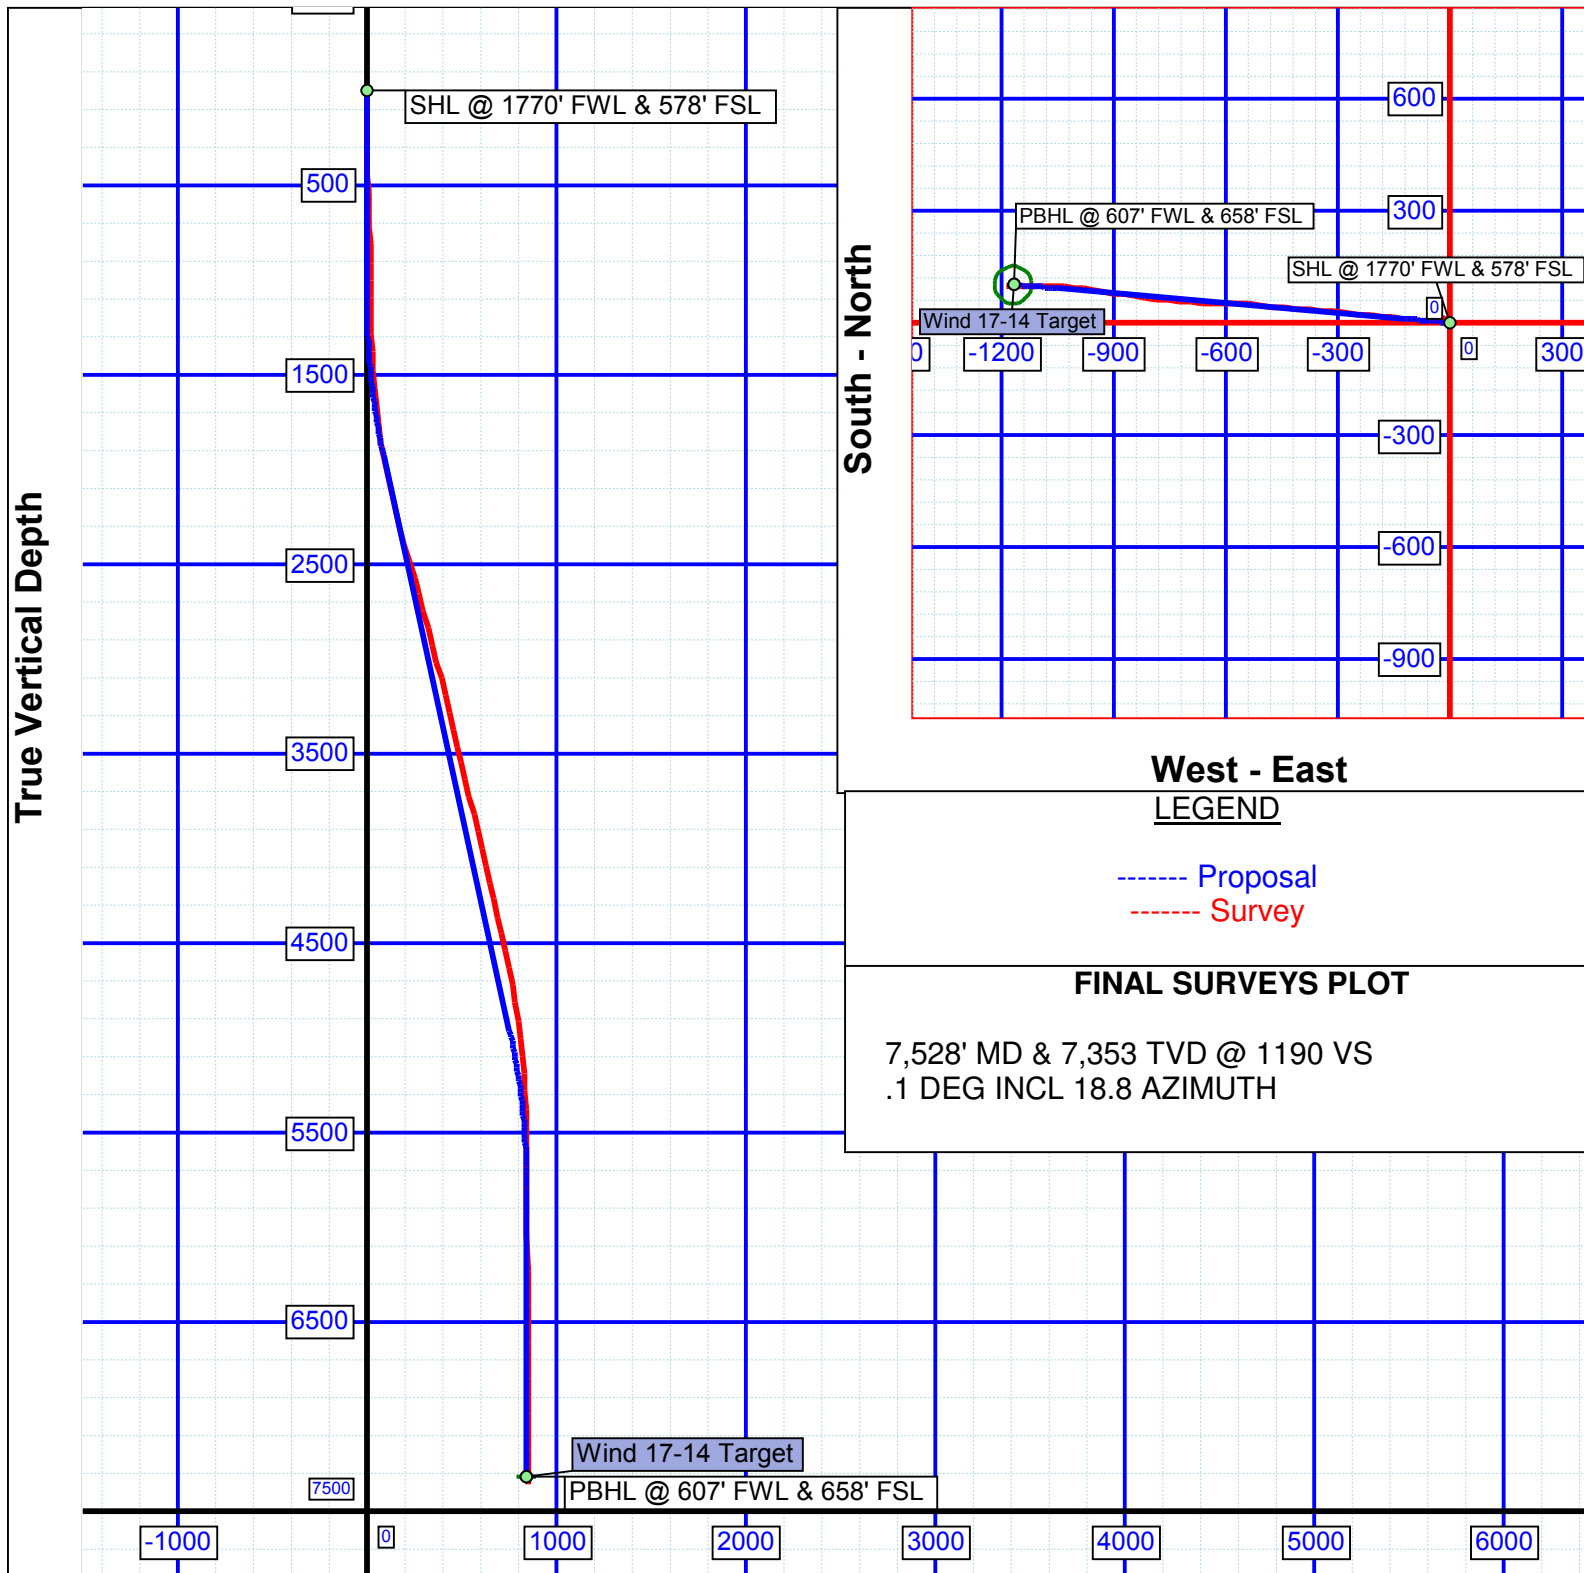

**Vertical Section (1000 Ft/Div) VSP: 319.00°**