




Job Number: Wind 17-14 Pad
Company: Trilogy Resources, LLC
Lease/Well: Wind 17-23
Location: SEC 17 T4N R67W
Rig Name: Cade 25
State/County: CO/ Weld
Country: USA
API Number: 05-123-36436

Elevation (To MSL): 4841.00 ft
RKB: 13.00 ft
Projection System: US State Plane 1983
Projection Group: Colorado Northern Zone
Projection Datum: GRS80
Magnetic Declination: 8.62
Grid Convergence: 0.38763 E
Date: Sunday, July 21, 2013

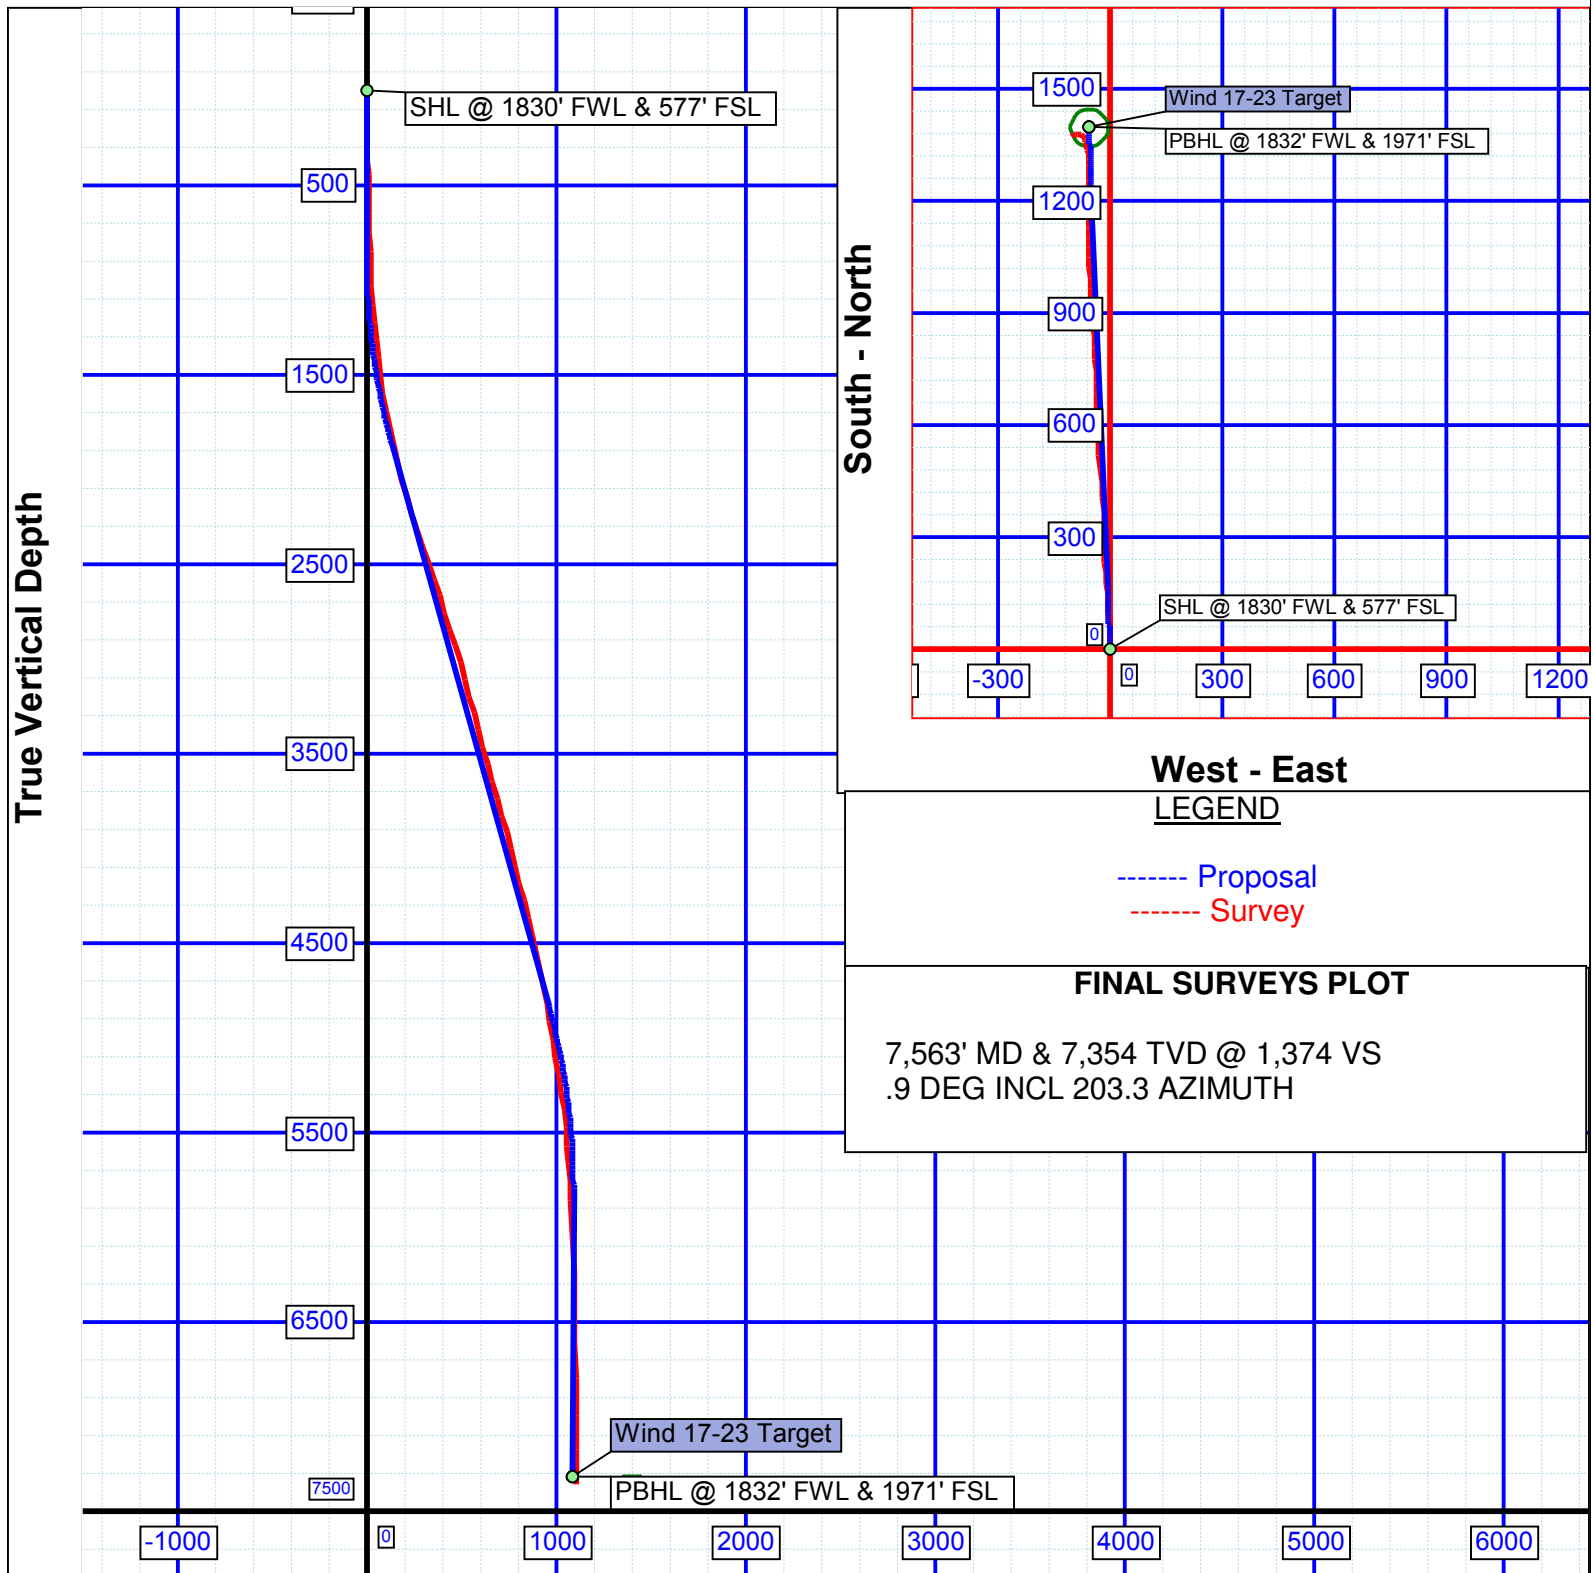

Vertical Section (1000 Ft/Div) VSP: 319.00°