

**KERR-MCGEE OIL AND GAS ONSHORE LP**

**MAYER 35-34**

**SE SW 34 3N 66W 657' FSL 1,952' FWL**

**WELD,COLORADO**

**07/31/2013**

**AREA: S4**

**ROUTE: S45 Spud: 05/06/2008**

**WINS No.: 94351**

**AFE/WO#: 88380486**

**API#: 0512325726**

**GL: 4987**

**KB: 4999**

**MTD: 7680**


**TVD: 7583**

**LOG MD:**

**PBMD: 7640**

**PBTVD: 7543**

**Directions: WCR 31 AND WCR 26, 1/2 EAST, 1/4 NORTH EAST TO LOC.**

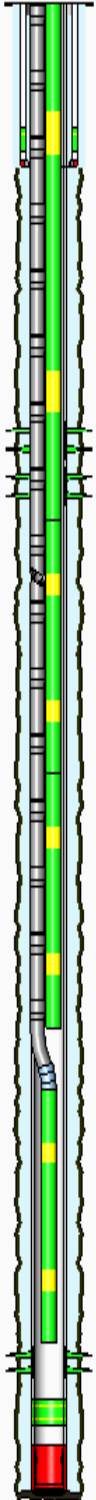

<u>HOLE SECTIONS</u>	<u>Size</u>	<u>Top</u>	<u>Btm</u>	<u>TD Date</u>					
SURFACE	12.25	12	870	05/07/2008					
PRODUCTION	7.88	870	7680	05/10/2008					
<u>TUBULARS</u>	<u>Tool Type</u>	<u>Joints</u>	<u>Size</u>	<u>Weight</u>	<u>Grade</u>	<u>Thread</u>	<u>Top D</u>	<u>Bottom D</u>	
<b>SURFACE CASING</b>									
	Casing	18	8.63	24.00	J-55	STC	12	814	
	Baffle	1	8.63		J-55		814	814	
	Casing	1	8.63	24.00	J-55	STC	814	859	
	Casing Shoe	1	8.63		J-55		859	860	
<b>PRODUCTION CASING</b>									
	Casing	174	5.50	17.00	I-80	LTC	12	7641	
	Latch Down Baffle	1	5.50				7641	7641	
	Casing	1	5.50	17.00	I-80	LTC	7641	7668	
	Casing Shoe	1	5.50				7668	7669	
<b>PRODUCTION TUBING</b>									
		238	2.38	4.70	J-55	8RD EUE	12	7492	
	XN Profile Nipple	1	2.38				7492	7493	
	Notched Collar	1	2.38				7493	7494	
<u>CEMENT JOBS</u>	<u>Stage</u>	<u>Sacks</u>	<u>Cement Jobs</u>				<u>Top D</u>	<u>Btm D</u>	<u>cbl</u>
<b>SURFACE CASING</b>									
	PRIM CMT 1ST STAGE	390	LEAD	SWIFTC	CEM - HOT		12	860	No
<b>PRODUCTION CASING</b>									
	PRIM CMT 1ST STAGE	40	SPACER	35/65	POZ-MIX		2360	3800	Yes
	PRIM CMT 1ST STAGE	315	LEAD	35/65	POZ-MIX		3800	6850	Yes
	PRIM CMT 1ST STAGE	110	TAIL	50/50	POZ-MIX		6850	7670	Yes
<b>PRODUCTION CASING</b>									
	ONE INCH JOB						90	3050	No
<u>PERFORATIONS</u>									
<u>Formation</u>	<u>Zone</u>	<u>Top</u>	<u>Btm</u>	<u>Date</u>	<u>Reason</u>	<u>Comments</u>			
NIOBRARA	B	7308	7318	06/19/2008	PRODUCTION	Nio "B"			
NIOBRARA	C	7377	7389	06/19/2008	PRODUCTION	Nio "C"			
CODELL		7528	7548	06/18/2008	PRODUCTION				

**Comments:**