

Well Name: Powell DV08B-23 H23 4101

API #: 05-103-11921-0000

Location: Sec. 23-101W-3S

KB:


GL: 6,753'

County/St: Rio Blanco, CO

Created By: B. Hoyer

Date: 08/08/2013

Current Wellbore

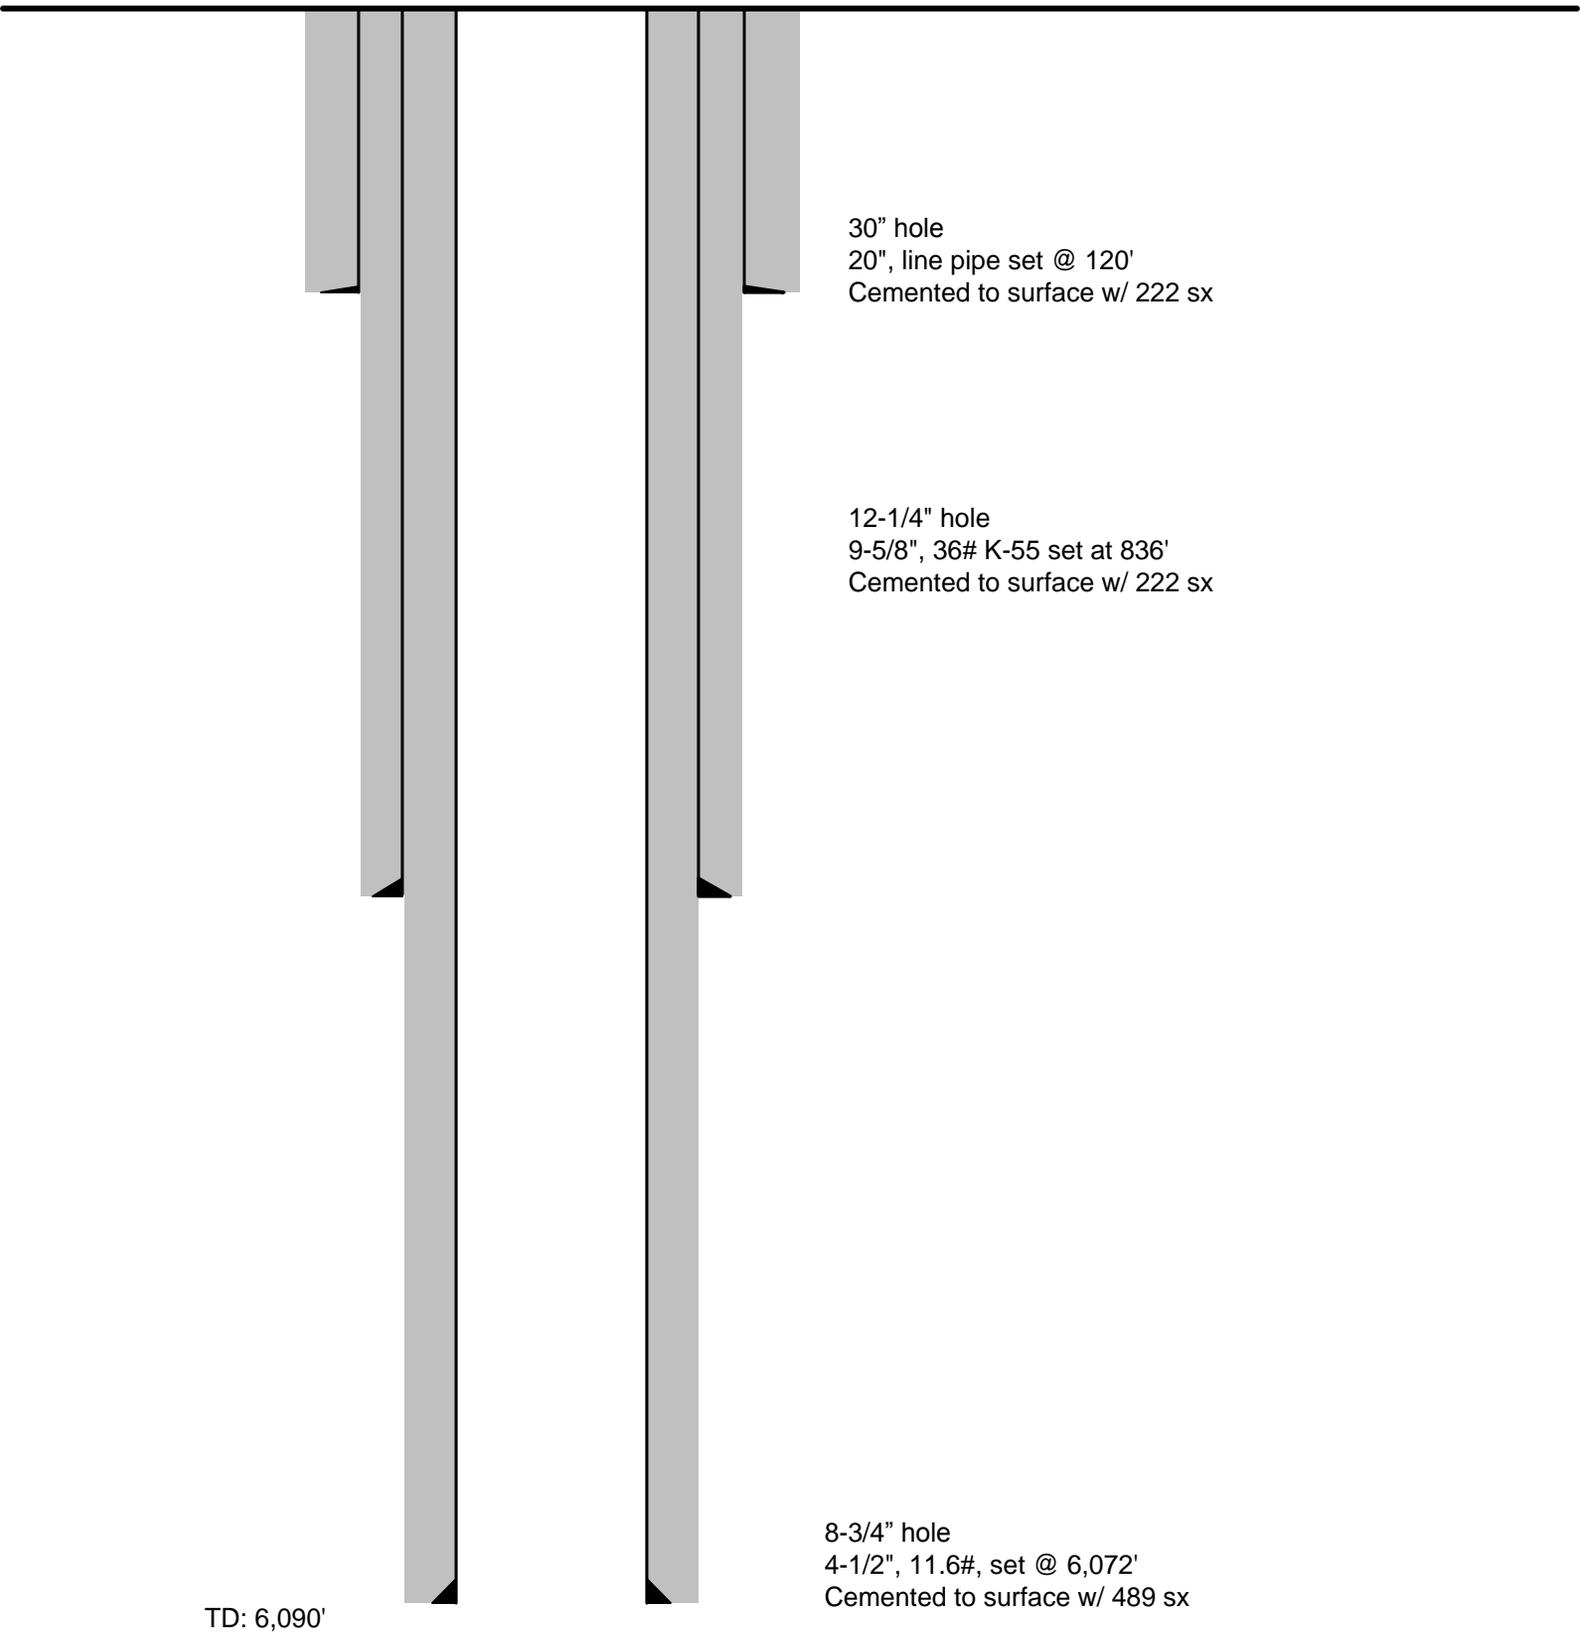

30" hole
20", line pipe set @ 120'
Cemented to surface w/ 222 sx

12-1/4" hole
9-5/8", 36# K-55 set at 836'
Cemented to surface w/ 222 sx

8-3/4" hole
4-1/2", 11.6#, set @ 6,072'
Cemented to surface w/ 489 sx

TD: 6,090'