


Well Name: STATE 02-36

VERTICAL - ORIGINAL HOLE, 8/16/2013 7:59:39 AM

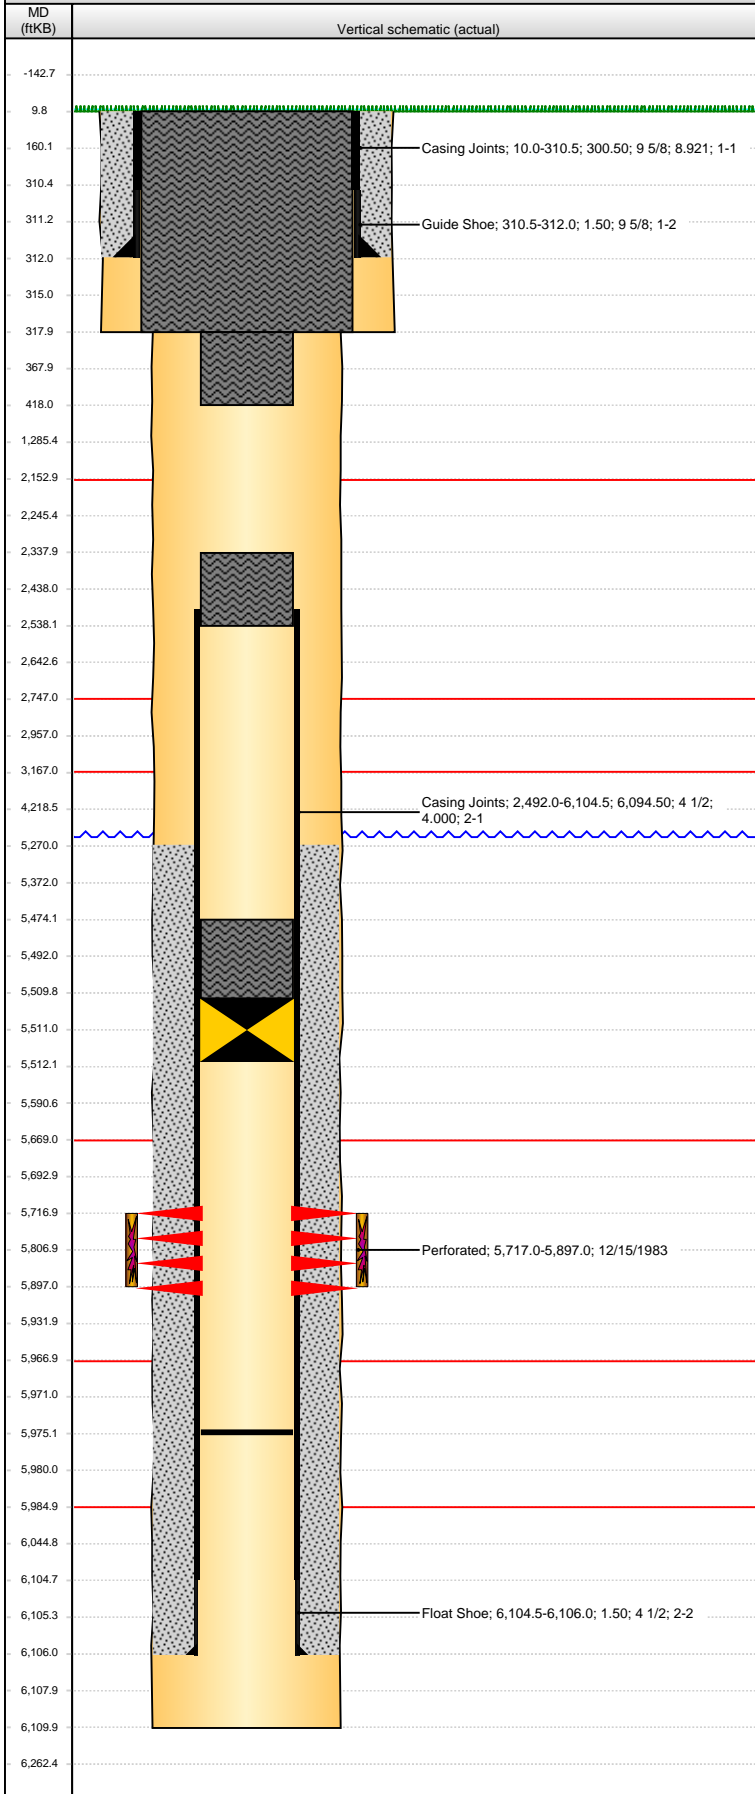

Well Header

API 05-069-06204	Business Unit WATTENBERG	District 15	Well Config VERTICAL
Original KB Elevation (ft) 5,048.00	KB - GL / MSL (ftKB) 10.00	Spud Date 11/24/1983	P & A Date 6/28/2013

Comment

Directions To Well

X-RDS OF CLR 1 & 40 S .5 W.3 S .1 INTO

Congressional Location

Quarter 1	Quarter 2	Quarter 3 NW	Quarter 4 SE	Section 36	Township 4 N	Twship N...	Range 69 W	Rng E/W Dir
-----------	-----------	-----------------	-----------------	---------------	-----------------	-------------	---------------	-------------

Bottom Hole Location

North-South Distance (ft)	From N or S Line	East-West Distance (ft)	From E or W Line
---------------------------	------------------	-------------------------	------------------

Plug Back Total Depths

Date	Depth (ftKB)	Method	Com
9/10/1993	5,975.0	TAG	

Wellbore Sections

Section Des	Size (in)	Act Top (ftKB)	Act Btm (ftKB)
SURFACE	12 1/4	10.0	318.0
PRODUCTION	7 7/8	318.0	6,110.0

Zone Statuses

Zone Name	Status Date	Status	Job
NIOBRARA	1/4/1984	PR	DRILLING/COMPLETION - ORIGINAL, 11/24/1983 00:00
NIOBRARA	6/28/2013	P&A	ABANDON WELL, 6/25/2013 06:00

Casing Strings

Surface, 312.0ftKB

Casing Description	Run Date	OD (in)	Wt/Len (l...)	Grade	Top (ftKB)	MD (ftKB)
Surface	11/24/1983	9 5/8	36.00	?	10.0	312.0

Production, 6,106.0ftKB

Casing Description	Run Date	OD (in)	Wt/Len (l...)	Grade	Top (ftKB)	MD (ftKB)
Production	12/8/1983	4 1/2	11.60	N-80	10.0	6,106.0

Cement

Description	Top Depth (ftKB)	Bottom Depth (ftKB)
SURFACE CASING CEMENT	10.0	312.0
PRODUCTION CASING CEMENT	5,270.0	6,106.0
Cement Plug	5,474.0	5,510.0
Cement Plug	318.0	418.0
Cement Plug	10.0	318.0
Cement Plug	2,338.0	2,538.0

Tubing Components

Item Des	OD (in)	Wt (lb/ft)	Grade	Jts	Len (ft)	Btm (ftKB)	Btm (TVD) (ftKB)

Perforation Data

Zone	Brnch/St g	Entered Shot Total	Top (ftKB)	Btm (ftKB)	Date
NIOBRARA, ORIGINAL HOLE		108	5,717.00	5,897.00	12/15/1983

Stimulations & Treatments

Date	Zone	Primary Job Type
12/16/1983	NIOBRARA, ORIGINAL HOLE	DRILLING/COMPLETION - ORIGINAL
Technical Result	Tech Result Details	Tech Result Note

Comment

Other In Hole

Run Date	Des	OD (in)	Top (ftKB)	Btm (ftKB)
6/26/2013	Cast Iron Bridge Plug	4	5,510.0	5,512.0

Logs

Date	Type	Top (ftKB)	Btm (ftKB)
6/26/2013	CBL/CCL/GR	5,000.0	5,567.0