WELLBORE DIAGRAM

Bonanza Creek Energy
North Platte J-F-28HZ

SHL: 782' FSL & 568' FWL SWSW
BHL: 475' FSL & 1018' FWL
Sec 28 T5N R63W
Weld County, CO
05-123-36024

Spud Date: 9/28/2012

KB Elev	4623'	ft
GL Elev	4608'	ft
KB to GL	15'	ft

Updated Date
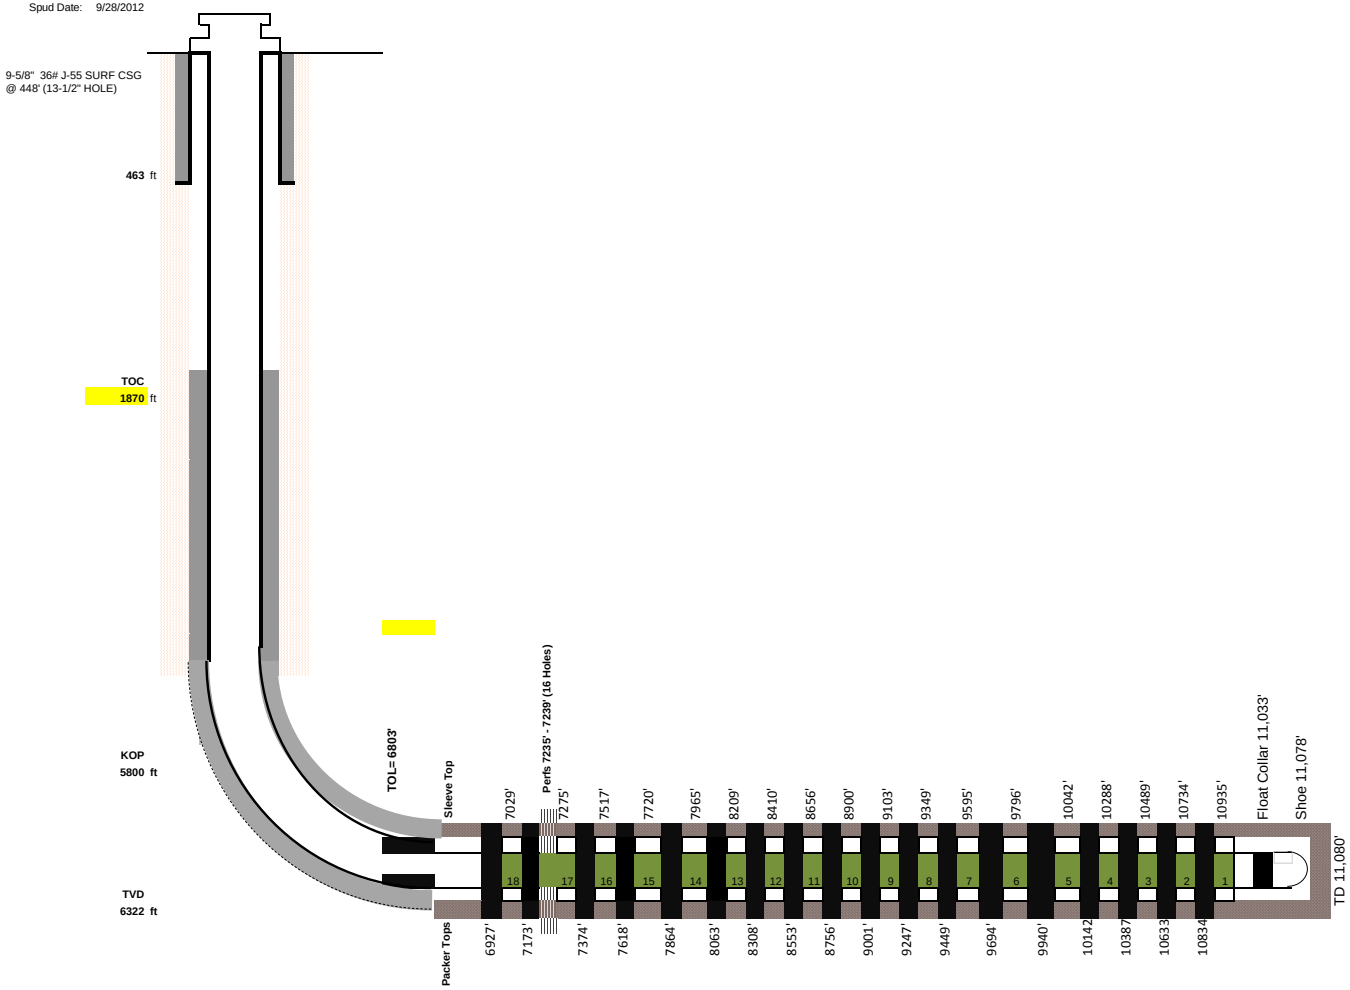
2/22/2012