| | | | | | |
|---|---|---|---|---|---|
| **Company:** | **US ROCKIES REGION** | | | **Site:** | **MILLER FEDERAL 5-31** |
| **Project:** | **COLORADO-WELD-NAD83-UTM13** | | | **Common Well Name:** | **MILLER FEDERAL 5-31** |
| API No: | 0512321742 | Datum: | RKB | Section: 31 | Div of Quarter Section: SW |
| Latitude: | 40.182640° | Elevation: | 4,842.0usft | Township: 3 N | Div of Section: NW |
| Longitude: | -104.827897° | Water Depth: | 4,830.0usft | Range: 66 W | |

| Casing Information | Casing Size & Weight | Cement Fluid (sacks) | Cement Depths (ft) | Schematic (8/21/2013) | Hole Size (in) | MD / PBMD (usft) | Perforation Intervals (usft) |
|---|---|---|---|---|---|---|---|
| SURFACE CASING - Set @ 619.0usft | 8.625in, | , 3% CACL2 1/4 #/sk Flocel, 485 | 12 (TOC)<br>619 | 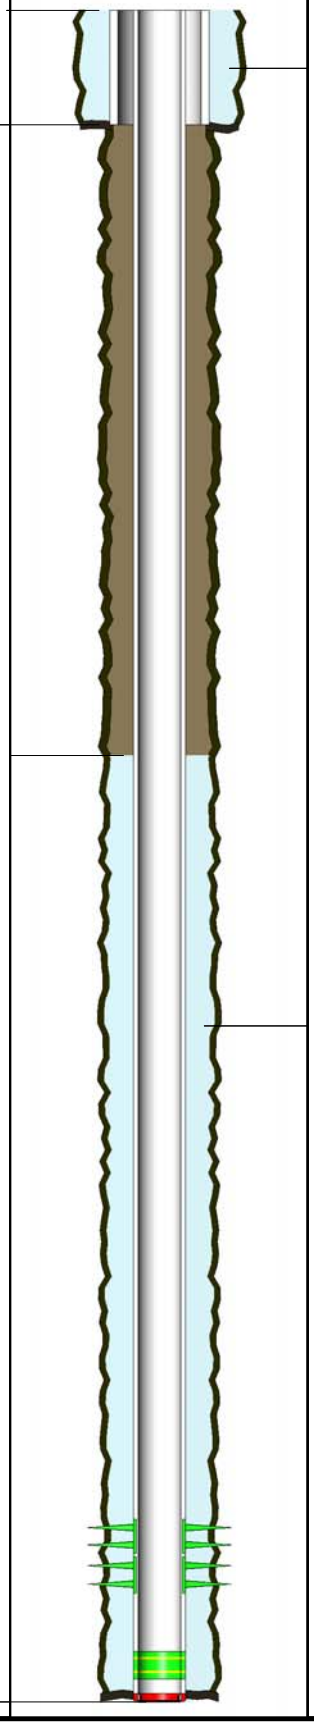 | 12.250 | | |
| PRODUCTION CASING - Set @ 7,918.0usft | 4.500in, | , 14.2ppg, 205<br>, 10.5ppg, 110<br>, 12, 110 | 3970 (TOC) | | 7.875 | | 7,758 - 7,770 - J SAND<br>7,760 - 7,770 - J SAND<br>7,784 - 7,794 - J SAND<br>7,782 - 7,810 - J SAND |
| | 4.500in, | | 7918 | | | MD: 7,912<br>PBMD: 7,890 | |