

Physical Address: 345 Comanche St.
Mail to: Box 384, Kiowa, CO 80117
Ph. 303-621-8672 - Fax 303-621-7749
www.highprairiesurvey.com


Job # 12139 EASY GO #6

Inv # 2638

High Prairie Surveying of Kiowa, Colorado, in accordance with a request from **WIEPKING FULLERTON**, has determined the location of **EASY GO #6** to be **2020 feet FNL**, and **1958 feet FWL**, (90° off Section lines) of **SECTION 15**, Township **6s**, Range **54w** of the 6th Principal Meridian, **Lincoln County**, Colorado.

Date: Staked on 08/06/13 drawn on 08/09/13.


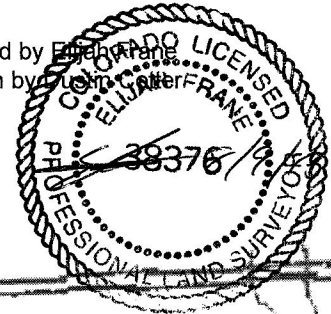

1000' Hydrology Map

C.R. 4B

There is an area of dry creek bed located approximately 949' Southeast of proposed well pad at its closest point.

WIEPKING FULLERTON
NW 1/4 SEC. 15-6-54W
EASY GO #6
LINCOLN, Co. COLORADO

